

MISSISSIPPI
BOARD OF WATER COMMISSIONERS
416 North State Street
Jackson, Mississippi 39201

CODED

WATER WELL DRILLERS LOG

COASTAL DRILLING & SERVICE CO. *Harrison*

ROUTE 1 BOX 818

county well located

6/18/73
date well completed

LANDOWNER: *BILOXI, MISS.*

description of formations encountered

from to

Southeastern Scientific Supply Co. Gulfport
(mailing address)

<i>Top Soil</i>	<i>1</i>	<i>5</i>
<i>White Sand</i>	<i>5</i>	<i>45</i>
<i>Sugar Sand</i>	<i>45</i>	<i>60</i>
<i>Soft Blue Clay</i>	<i>60</i>	<i>120</i>
<i>White Sand</i>	<i>120</i>	<i>145</i>
<i>Soft Blue Clay</i>	<i>145</i>	<i>200</i>
<i>Hard Blue Clay</i>	<i>200</i>	<i>345</i>
<i>fine water sand</i>	<i>345</i>	<i>375</i>
<i>Coarse Water Sand</i>	<i>375</i>	<i>400</i>

WELL LOCATION:

sec. *15* T. *7* S. R. *11* E.
(distance) (direction) (nearest town)
0.1 miles *N* *Gulfport*

WELL PURPOSE: *Water*
(home, irrigation, municipal, industrial)

WELL COMPLETION DATA:

(1) diameter (inches) *2"*
(2) total depth (feet) *400'*
(3) static water level (feet) *4'* below top of ground
(4) casing *galv* *390'*
(material) (depth)

CODED

(size) If telescope see back.
(5) screen *10'* *390'*
(length) (depth to top)
2" *SS*
(size) (material)

(6) pump *1/2* *18*
(HP) (yield gpm)
2 hp
(type power)

(7) electric log *no*
(yes or no)

(organization running log)

(8) how well bottom plugged
2" thick mud

DRILLERS REMARKS:


None

SEP 7 1973

MISS. 20, 05
LATE 2 000

If well telescopes please
sketch and show depths.

GROUND LEVEL

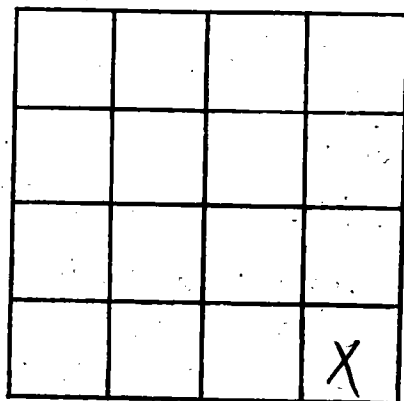

SECTION _____

Please indicate well location X.

ADDITIONAL INFORMATION

If more than one screen,
show locations of each on sketch.