

HARRISON
L 383
11-15-73

MISSISSIPPI
 BOARD OF WATER COMMISSIONERS
 416 North State Street
 Jackson, Mississippi 39201

CODED

WATER WELL DRILLERS LOG

11-15-73 19 P. V. MOORE HARRISON
 date well completed firm name county well located

LANDOWNER: J. C. GRIMES
RT 3 Box 346
GOLSPRINT MISS
 (mailing address)

description of formations encountered	from	to
TOP SOIL	0	15
white sand	15	40
blue clay	40	280
blue sand	280	294

WELL LOCATION:
 sec. 10 T. 7 N. R. 11 E.
5 1/2 miles N of GOLSPRINT
 (distance) (direction) (nearest town)

WELL PURPOSE:
 (home, irrigation, municipal, industrial)

WELL COMPLETION DATA:

(1) diameter (inches) 2"

(2) total depth (feet) 294'

(3) static water level (feet) 58' below above top of ground.

(4) casing galv 284'
 (material) (depth)
 (size) If telescope see back.

(5) screen 10' 294'
 (length) (depth to top)
2" SS
 (size) (material)

(6) pump 1 8
 (HP) (yield gpm)
E
 (type power)

(7) electric log _____
 (yes or no)

 (organization running log)

(8) how well bottom plugged _____


CODED

DRILLERS REMARKS:
See above

DEC 10 1973

If well telescopes please sketch and show depths.

GROUND LEVEL

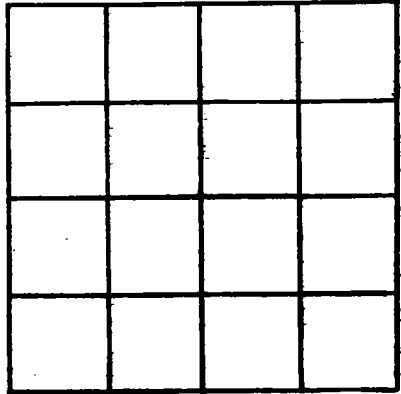

SECTION _____

Please indicate well location X.

ADDITIONAL INFORMATION

If more than one screen, show locations of each on sketch.