

**HARRISON**  
**L 388**  
**2-25-74**

**MISSISSIPPI**  
**BOARD OF WATER COMMISSIONERS**  
 416 North State Street  
 Jackson, Mississippi 39201

**WATER WELL DRILLERS LOG**

2-25-74 19 R. J. Mooker HARRISON  
 date well completed firm name county well located

LANDOWNER: L. M. PLUNKETT  
Redefer RD  
Gulfport, MISS  
 (mailing address)  
 WELL LOCATION:  
 sec. 9 T. 2 N. R. 11 E.  
5 miles N of Gulfport  
 (distance) (direction) (nearest town)

description of formations encountered	from	to
TOP SOIL	0	10
TOP SAND	10	30
Blue Clay	30	240
Blue Sand	240	245
Blue Clay	245	470
orange Gravel Sand	470	515

WELL PURPOSE:  
 Home,  Irrigation,  municipal,  Industrial


WELL COMPLETION DATA:  
 (1) diameter (inches) 2"  
 (2) total depth (feet) 515'  
 (3) static water level (feet) 4' <sup>below</sup> above top of ground.  
 (4) casing galv 505'  
 (material) (depth)  
         if telescope see back.  
 (size)  
 (5) screen 10" 515'  
 (length) (depth to top)  
2" 55'  
 (size) (material)  
 (6) pump 1 10  
 (HP) (yield gpm)  
8  
 (type power)  
 (7) electric log           
 (yes or no)  
          
 (organization running log)  
 (8) how well bottom plugged           
well there

**CODED**

DRILLERS REMARKS:

If well telescopes please sketch and show depths.

GROUND LEVEL

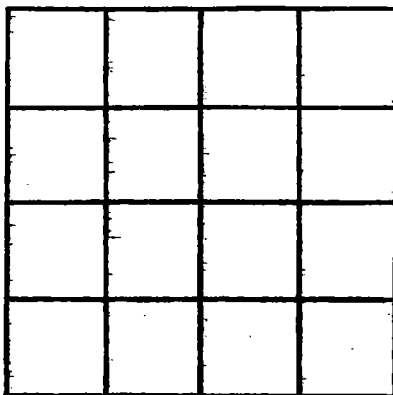

SECTION \_\_\_\_\_

Please indicate well location X.

ADDITIONAL INFORMATION

If more than one screen, show locations of each on sketch.