

HARRISON

L 391

3-20-74

MISSISSIPPI
 BOARD OF WATER COMMISSIONERS
 416 North State Street JACKSON, Mississippi 39201 **CODED**

WATER WELL DRILLERS LOG

date well completed 3/20 1974 firm name Mr B Drilling Co. Inc. county well located Harrison

LANDOWNER: Marley Corp

description of formations encountered

from

to

Cresate Rd

Sand 0 20

Gulfport, Miss. (mailing address)

Blue Clay 20 70

WELL LOCATION:

sec 15 T 7 R 11
 2 miles N of Cribout
 (distance) (direction) (nearest town)

Sand 70 90

Blue Clay 90 95

Sand 95 120

Blue Clay 120 155

Sand 155 160

Blue Clay 160 180

WELL PURPOSE: Concrete Head (home, irrigation, municipal, industrial)

Blue Clay Sand 180 183

Blue Clay 183 195

WELL COMPLETION DATA:

- (1) diameter (inches) 4x2
- (2) total depth (feet) 762
- (3) static water level (feet) 2 below above top of ground.

Sand 195 200

Blue Clay 200 230

Sand 230 240

Blue Clay 240 330

Sand 330 345

Blue Clay 345 695

Sand 695 757

Blue Clay 757 762

Bottom 762

- (4) casing PVC Total, (material) (depth) 4x2 if telescope see back. (size)

- (5) screen 10ft 745 (length) (depth to top)

- (6) pump 3 45 (HP) (yield gpm)

- (7) electric log No (yes or no)

(organization running log)


- (8) how well bottom plugged 2 1/2" PVC Valve

DRILLERS REMARKS:

MAY 20 1974
 MISSISSIPPI WATER BOARD

If well telescopes please sketch and show depths.

GROUND LEVEL

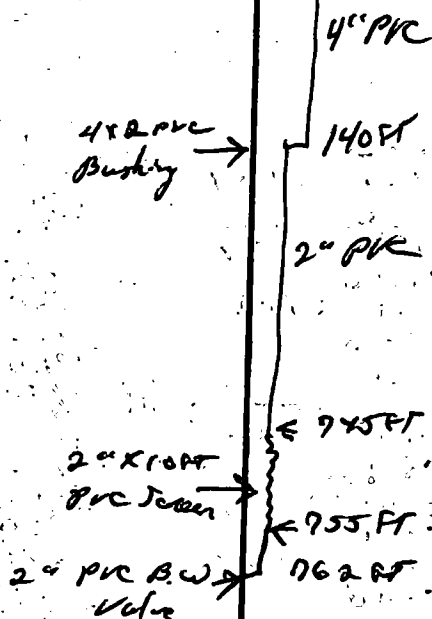

SECTION 13

Please indicate well location X.

ADDITIONAL INFORMATION

If more than one screen, show locations of each on sketch.