

HARRISON

MISSISSIPPI
BOARD OF WATER COMMISSIONERS
416 North State Street
Jackson, Mississippi 39201

WATER WELL DRILLERS LOG

July 12 1973 MC Gill well works Harrison
date well completed first name county well located

LANDOWNER: Clyde Humbert
P.O. Box 541
Biloxi, Miss
(mailing address)

description of formations encountered
Sand from 0 to 30

WELL LOCATION:
sec. 13 T 7 N R 11 E
8 miles East of Gulfport
(distance) (direction) (nearest town)

WELL PURPOSE: Domestic
(home, irrigation, municipal, industrial)

WELL COMPLETION DATA:
(1) diameter (inches) 2"
(2) total depth (feet) 30'
(3) static water level (feet) 4' below top of ground
(4) casing plastic 20'
(material) (depth)
(size) If telescope see back.
(5) screen 10'
(length) (depth to top)
2" plastic
(size) (material)
(6) pump 1/2 10
(HP) (yield gpm)
Electric
(type power)
(7) electric log no
(yes or no)
(organization running log)

CODED

(8) how well bottom plugged sand
shank


DRILLERS REMARKS:

MISSISSIPPI
MAY 28 1974
WATER

MISS. Bd. of WATER

If well telescopes please sketch and show depths.

GROUND LEVEL

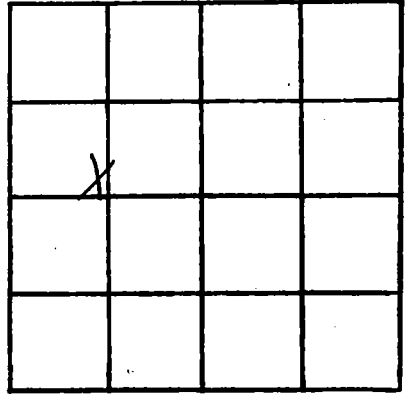

SECTION 13

Please indicate well location X.

ADDITIONAL INFORMATION

If more than one screen,
show locations of each on sketch.