

**MISSISSIPPI  
BOARD OF WATER COMMISSIONERS**  
416 North State Street  
Jackson, Mississippi 39201

**WATER WELL DRILLERS LOG**

S.W.  
L. 393  
HARRISON  
7-18-73

July 18 1973 MC Geo Well Works Harrison  
date well completed firm name county well located

LANDOWNER: M.C. Morgan  
4708 Oak Ave.  
Shelport Ms.  
(mailing address)

description of formations encountered	from	to
sand	0	12
clay	12	40
concrete sand	40	60

WELL LOCATION:  
sec 24 T 7 N R 11 E  
3 miles NE of Shelport  
(distance) (direction) (nearest town)

WELL PURPOSE: irrigation  
(home, irrigation, municipal, industrial)

WELL COMPLETION DATA:

(1) diameter (inches) 2"

(2) total depth (feet) 60'

(3) static water level (feet) 3' below top of ground

(4) casing plastic 50'  
(material) (depth)

(size) if telescope see back.

(5) screen 10'  
(length) (depth to top)

2" plastic  
(size) (material)

(6) pump 1/2 8  
(HP) (yield gpm)

electric  
(type power)

(7) electric log No  
(yes or no)

(organization running log)

(8) how well bottom plugged sand  
shale

**CODED**


MISSISSIPPI BOARD OF WATER COMMISSIONERS  
JUL 22 1974

DRILLERS REMARKS:

MISS. Bd. OF WATER COMMISSIONERS

If well telescopes please sketch and show depths.

GROUND LEVEL

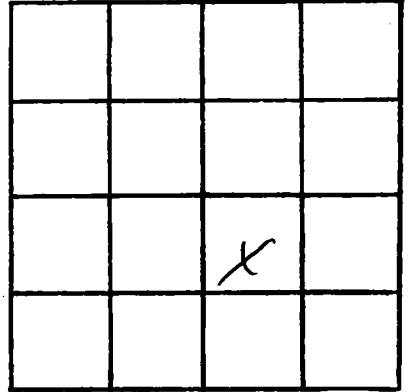

SECTION 24

Please indicate well location X.

ADDITIONAL INFORMATION

If more than one screen,  
show locations of each on sketch.