

L 394
 HARRISON
 5-11-73

MISSISSIPPI
 BOARD OF WATER COMMISSIONERS
 416 North State Street
 Jackson, Mississippi 39201

WATER WELL DRILLERS LOG

5/11 1973 McGil well works Harrison
 date well completed firm name county well located

LANDOWNER: Wilton Richardson
Rt. 3, Box 510
Guilford miss
 (mailing address)

description of formations encountered	from	to
	clay	0
coarse sand	26	55

WELL LOCATION:
 sec. 36 T. 7 N R. 11 E
S miles NE of Guilford
 (distance) (direction) (nearest town)

WELL PURPOSE: home
 (home, irrigation, municipal, industrial)

- WELL COMPLETION DATA:
- (1) diameter (inches) 2"
 - (2) total depth (feet) 55'
 - (3) static water level (feet) 14' below above top of ground.
 - (4) casing plastic 45'
 (material) (depth)
 (size) if telescope see back.
 - (5) screen 10' -
 (length) (depth to top)
2" plastic
 (size) (material)
 - (6) pump 1 10
 (HP) (yield gpm)
electric
 (type power)
 - (7) electric log no
 (yes or no)


(organization running log)
 (8) how well bottom plugged sand
start

DRILLERS REMARKS:

CODED

If well telescopes please sketch and show depths.

GROUND LEVEL

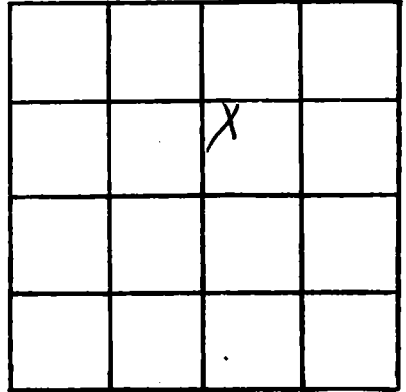

SECTION 36

Please indicate well location X.

ADDITIONAL INFORMATION

If more than one screen, show locations of each on sketch.