

**HARRISON**  
**L 399**  
**S-28-74**

MISSISSIPPI  
 BOARD OF WATER COMMISSIONERS  
 416 North State Street  
 Jackson, Mississippi 39201  
**CODED**  
**WATER WELL DRILLERS LOG**

5-28-74 19 R. J. Moore HARRISON  
 date well completed firm name county well located

LANDOWNER: LYNN STRINGER  
RT 3 Box 300 H  
C. L. SPART, MS  
 (mailing address)

description of formations encountered	from	to
<u>TOP Salt</u>	<u>0</u>	<u>16</u>
<u>White Sand</u>	<u>16</u>	<u>20</u>
<u>Blue Clay</u>	<u>20</u>	<u>220</u>
<u>Blue Sand</u>	<u>220</u>	<u>242</u>

WELL LOCATION:  
 sec. 35 T. 7 N. R. 11 E. W. W  
2 miles E of NUGENT  
 (distance) (direction) (nearest town)

WELL PURPOSE:  
 (home, irrigation, municipal, industrial)

WELL COMPLETION DATA:

(1) diameter (inches) 2"

(2) total depth (feet) 242'

(3) static water level (feet) 26' below top of ground.

(4) casing PVC, 227'  
 (material) (depth)  
 (size) If telescope see back.

(5) screen 15', 227'  
 (length) (depth to top)  
2", PVC  
 (size) (material)

(6) pump \_\_\_\_\_ (HP) \_\_\_\_\_ (yield gpm)  
 (type power)

(7) electric log \_\_\_\_\_ (yes or no)  
 (organization running log)


(8) how well bottom plugged  
Bottom

DRILLERS REMARKS:

**CODED**

If well telescopes please sketch and show depths.

GROUND LEVEL

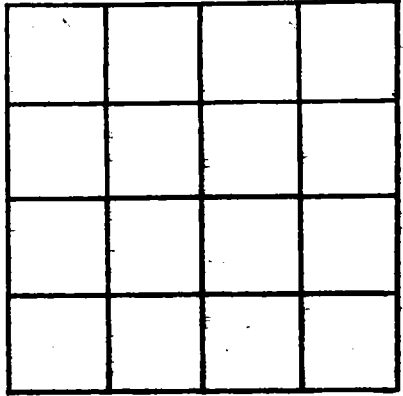

SECTION \_\_\_\_\_

Please indicate well location X.

ADDITIONAL INFORMATION

If more than one screen, show locations of each on sketch.