

HARRISON
L402
10-20-73

MISSISSIPPI
BOARD OF WATER COMMISSIONERS
416 North State Street
Jackson, Mississippi 39201

CODED

WATER WELL DRILLERS LOG

COASTAL DRILLING & SERVICE CO.

Harrison
county well located

10/20/73
date well completed

ROUTE 1 BOX 618

LANDOWNER: Holt Co. BLOXIE, MISS

39537
description of formations encountered

from to

Sherton Motor Inn
Gulfport Miss
(mailing address)

Top Soil	1	3
Sharon Sand	3	17
Coarse water sand	17	45
Soft Blue Clay	45	68
White Sand	68	100
hard Blue Clay	100	210
Coarse water sand	210	265
hard Blue Clay	265	460
fine water sand	460	505
hard Blue Clay	505	695
fine water sand	695	710
Coarse water sand	710	842

WELL LOCATION:

sec. 8 T 7 N R 11 E
S W
miles (distance) of (direction) (nearest town)
Sardis

WELL PURPOSE: Water
(home, irrigation, municipal, industrial)

WELL COMPLETION DATA:

- (1) diameter (inches) 10 1/2"
- (2) total depth (feet) 842'
- (3) static water level (feet) 18 below top of ground.
- (4) casing Black 782' (material) (depth)
10 1/2" (size) if telescope see back.
- (5) screen 100' 782' (length) (depth to top)
6" (size) SS (material)
- (6) pump 30 250 (HP) (yield gpm)
Ele (type power)
- (7) electric log no (yes or no)


(organization running log)

(8) how well bottom plugged 6"
back wash valve

DRILLERS REMARKS:

big good well

CODED

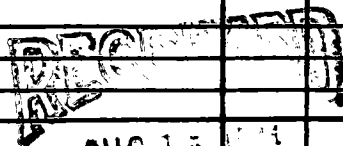


MISS. BD. OF WATER COMM.

If well telescopes please sketch and show depths.

GROUND LEVEL

200ft 10" Black pipe

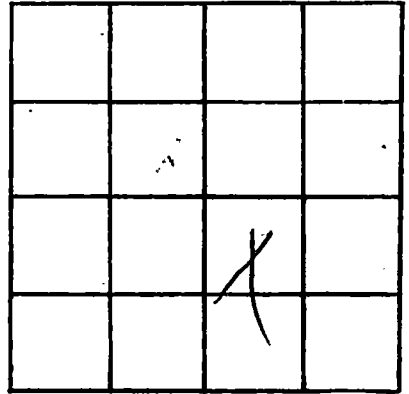

SECTION _____

Please indicate well location X.

ADDITIONAL INFORMATION

542' 6" Black pipe

60ft 6" S.S. Screen

6" backwash valve

If more than one screen, show locations of each on sketch.