

**Harrison**  
**L405**  
**10-7-74**  
**E-log #111**

SW  
 01806

**MISSISSIPPI**  
**BOARD OF WATER COMMISSIONERS**  
 416 North State Street  
 Jackson, Mississippi 39201

**WATER WELL DRILLERS LOG**

10-7- date well completed      1974 Singas Lumber Control Div. firm name      Harrison county well located

**LANDOWNER:**  
 City of Gulfport  
 Gulfport, Miss  
 (mailing address)

**WELL LOCATION:**  
 sec 28 T 7 S R 11 W  
 miles of (distance)      of (direction)      of (nearest town)


**WELL PURPOSE:** Municipal  
 (home, irrigation, municipal, industrial)

**WELL COMPLETION DATA:**

(1) diameter (inches) 16"  
 (2) total depth (feet) 808'  
 (3) static water level (feet) 35 below top of ground  
 (4) casing Steel 715' (material) (depth)  
16" if telescope see back. (size) 60' 8 10"  
 (5) screen 80' 715' (length) (depth to top)  
10" Stainless Steel W/W (size) (material)  
 (6) pump 100 1000 (HP) (yield gpm)  
Electric (type power)  
 (7) electric log Yes (yes or no)  
U.S.G.S. (organization running log)  
 (8) how well bottom plugged Valve

description of formations encountered	from	to
Red Clay Fill	0	6
Sand + fine gravel	6	100
Clay	100	145
Sand	145	153
Sandy shale	153	197
Shale	197	241
Sand	241	281
Shale + Sandy Shls	281	355
Sandy Shale	355	480
Shale	480	553
Sand	553	619
Shale	619	720
Sand	720	807
Shale, Hard	807	862
Sand, Shaly Shls	862	890
Shale + Sand	890	916
Sandy Hard	916	1002
Sandy Shale	1002	1008

**DRILLERS REMARKS:**

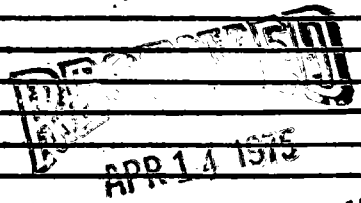

MISS. BD. OF WATER COM.

If well telescopes please sketch and show depths.

GROUND LEVEL


SECTION \_\_\_\_\_

Please indicate wall location X.

ADDITIONAL INFORMATION

If more than one screen, show locations of each on sketch.