

Harrison  
L 906  
11-3-73

MISSISSIPPI  
BOARD OF WATER COMMISSIONERS  
416 North State Street  
Jackson, Mississippi 39201

CODED

WATER WELL DRILLERS LOG

November 3, 1973 H.A. Hadwier Well Works Harrison  
date well completed firm name county well located

LANDOWNER: PAUL STINNETT	description of formations encountered	from	to
CANAL ROAD Gulfport, Miss. (mailing address)	yellow clay yellow sand yellow clay blue clay blue sand	0 35 70 145 475	35 70 165 475 525
WELL LOCATION: sec. 7 T. 7 S. R. 11 W. 6 miles NW of London (distance) (direction) (nearest town)			
WELL PURPOSE: HOME (home, irrigation, municipal, industrial)			
WELL COMPLETION DATA:			
(1) diameter (inches) 2 inch			
(2) total depth (feet) 525 ft.			
(3) static water level (feet) 45 below top of ground.			
(4) casing GALV. 515 ft. (material) (depth)			
2 inch (size) if telescope see back.			
(5) screen 10 ft., 515 ft. (length) (depth to top)			
2 inch, STAINLESS STEEL (size) (material)			
(6) pump 1 (HP) 7 (yield gpm)			
Electric (type power)			
(7) electric log No (yes or no)			
(organization running log)			
(8) how well bottom plugged Ball Check			
DRILLERS REMARKS:			


RECEIVED

NOV - 4 1974

MISS. BD. OF WATER COMM

If well telescopes please sketch and show depths.

GROUND LEVEL

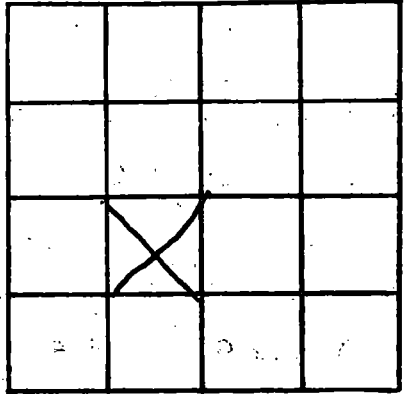

SECTION 2

Please indicate well location X.

ADDITIONAL INFORMATION

If more than one screen, show locations of each on sketch.