

Harrison
L 407
11-13-73

MISSISSIPPI
 BOARD OF WATER COMMISSIONERS
 416 North State Street
 Jackson, Mississippi 39201

CODED

WATER WELL DRILLERS LOG

November 13 19 73 H.A. Hadwier Well Works HARRISON
 date well completed firm name county well located


LANDOWNER: <u>Russell Randolph</u> <u>Robinson Road</u> <u>Gulfport, Miss.</u> (mailing address)	description of formations encountered	from	to
	<u>yellow clay</u>	<u>0</u>	<u>60</u>
	<u>yellow sand</u>	<u>60</u>	<u>100</u>
	<u>yellow clay</u>	<u>100</u>	<u>170</u>
	<u>blue clay</u>	<u>170</u>	<u>455</u>
	<u>blue sand</u>	<u>455</u>	<u>505</u>
WELL LOCATION:			
sec <u>2</u> T <u>7</u> S R <u>11</u> W <u>5</u> miles <u>NW</u> of <u>Landon</u> (distance) (direction) (nearest town)			
WELL PURPOSE: <u>HOME</u> (home, irrigation, municipal, industrial)			
WELL COMPLETION DATA:			
(1) diameter (inches) <u>2 inch</u>			
(2) total depth (feet) <u>50.5 ft.</u>			
(3) static water level (feet) <u>40</u> below above top of ground			
(4) casing <u>Galv.</u> <u>49.5 ft.</u> (material) (depth) <u>2 inch</u> if telescope see back. (size)			
(5) screen <u>10 ft.</u> <u>49.5 ft.</u> (length) (depth to top) <u>2 inch, STAINLESS STEEL</u> (size) (material)			
(6) pump <u>1</u> <u>7</u> (HP) (yield gpm) <u>Electric</u> (type power)			
(7) electric log <u>NO</u> (yes or no)			
(organization running log)			
(8) how well bottom plugged <u>Ball Check</u>			
DRILLERS REMARKS:			

RECEIVED
 NOV - 4 1974

MISS. BD. OF WATER COMM.

If well telescopes please sketch and show depths.

GROUND LEVEL

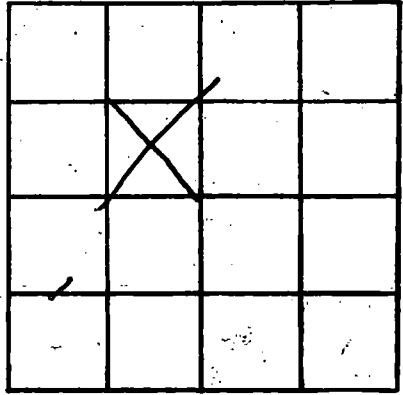

SECTION 2

Please indicate well location X.

ADDITIONAL INFORMATION

If more than one screen, show locations of each on sketch.