

Harrison
L-408
5-3-74

MISSISSIPPI
 BOARD OF WATER COMMISSIONERS
 416 North State Street
 Jackson, Mississippi 39201

CODED

WATER WELL DRILLERS LOG

May 3 1974 H.A. Ladover Well Works Harrison
 date well completed firm name county well located

LANDOWNER: Bell
Lambercht Road
Lyman, Miss.
 (mailing address)

description of formations encountered	from	to
<u>yellow clay</u>	<u>0</u>	<u>40</u>
<u>yellow sand</u>	<u>40</u>	<u>70</u>
<u>yellow clay</u>	<u>70</u>	<u>100</u>
<u>blue clay</u>	<u>100</u>	<u>475</u>
<u>blue sand</u>	<u>475</u>	<u>514</u>

WELL LOCATION:
 sec. 2 T. 7 S. R. 11 W.
5 miles NW of London
 (distance) (direction) (nearest town)

WELL PURPOSE: WATER
 (home, irrigation, municipal, industrial)

- WELL COMPLETION DATA:
- (1) diameter (inches) 2 inch
 - (2) total depth (feet) 514 ft.
 - (3) static water level (feet) 45 below top of ground.
 - (4) casing Galv. 504 ft.
 (material) (depth)
2 inch If telescope see back.
 (size)
 - (5) screen 10 ft. 504 ft.
 (length) (depth to top)
2 inch S.S. STEEL
 (size) (material)
 - (6) pump 1 7
 (HP) (yield gpm)
Electric
 (type power)
 - (7) electric log NO
 (yes or no)
- (organization running log)
- (8) how well bottom plugged Ball Check


RECEIVED

NOV 4 1974

DRILLERS REMARKS:

If well telescopes please sketch and show depths.

GROUND LEVEL

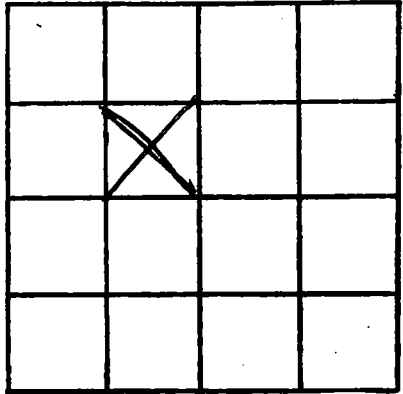

SECTION

2

Please indicate well location X.

ADDITIONAL INFORMATION

If more than one screen,
show locations of each on sketch.