

Harrison
L409
9-21-73

MISSISSIPPI
 BOARD OF WATER COMMISSIONERS
 416 North State Street
 Jackson, Mississippi 39201
WATER WELL DRILLERS LOG

RECORDED


September 21 1973 A.A. Ladwica Well Works HARRISON
 date well completed firm name county well located

LANDOWNER: <u>John Smallwood</u>	description of formations encountered	from	to
<u>Old Hwy. 49</u> <u>Gulfport, Miss.</u> (mailing address)			
WELL LOCATION: sec. <u>2</u> T <u>7</u> S R <u>11</u> W <u>3</u> miles <u>N</u> of <u>London</u> (distance) (direction) (nearest town)	<u>yellow clay</u>	<u>0</u>	<u>30</u>
	<u>yellow sand</u>	<u>30</u>	<u>60</u>
	<u>yellow clay</u>	<u>60</u>	<u>150</u>
	<u>blue clay</u>	<u>150</u>	<u>190</u>
	<u>blue sand</u>	<u>190</u>	<u>220</u>
WELL PURPOSE: <u>HOME</u> (home, irrigation, municipal, industrial)			
WELL COMPLETION DATA: (1) diameter (inches) <u>2 inch</u>			
(2) total depth (feet) <u>220 ft.</u>			
(3) static water level (feet) <u>00</u> below above top of ground.			
(4) casing <u>Galv.</u> , <u>210 ft.</u> (material) (depth) <u>2 inch</u> (size) if telescope see back.			
(5) screen <u>10 ft.</u> , <u>210 ft.</u> (length) (depth to top) <u>2 inch</u> , <u>Stainless Steel</u> (size) (material)			
(6) pump <u>1</u> , <u>6</u> (HP) (yield gpm) <u>Electric</u> (type power)			
(7) electric log <u>No</u> (yes or no)			
(organization running log)			
(8) how well bottom plugged <u>Ball Check</u>			
DRILLERS REMARKS:			

RECEIVED
NOV - 4 1974

If well telescopes please sketch and show depths.

GROUND LEVEL

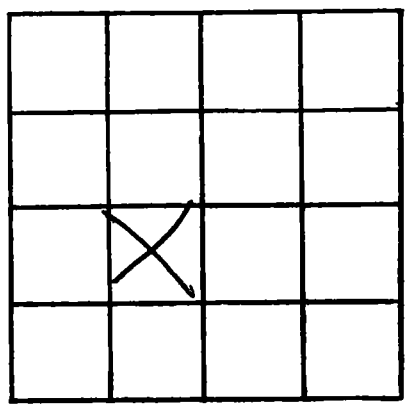

SECTION 2

Please indicate well location X.

ADDITIONAL INFORMATION

A series of horizontal lines for writing additional information.

If more than one screen, show locations of each on sketch.