

Harrison  
L 410  
7-13-74

MISSISSIPPI  
BOARD OF WATER COMMISSIONERS  
416 North State Street  
Jackson, Mississippi 39201

CODEN

WATER WELL DRILLERS LOG

MC Well Works Harrison  
firm name county well located

7/13/74 19  
date well completed

LANDOWNER:

Litchfield Plating Co  
2525 - 24th Street  
Sulphur, Miss.  
(drilling address)

description of formations encountered

from	to
0	65
65	138
138	172
172	197
197	252
252	312
312	388
388	415
415	587
587	631
631	689
689	757


WELL LOCATION:

sec Blue T8 N R 11 E  
4 S W  
4 miles (distance) of in Sulphur (direction) (nearest town)

WELL PURPOSE: Industrial  
(home, irrigation, municipal, industrial)

WELL COMPLETION DATA:

- (1) diameter (inches) 5.57" - 2 2/4"
- (2) total depth (feet) 757'
- (3) static water level (feet) 3 below above top of ground.
- (4) casing PVC 297'  
(material) (depth)  
 If telescope see back.  
(size)
- (5) screen 20' 237'  
(length) (depth to top)  
2" SS  
(size) (material)
- (6) pump 5 75  
(HP) (yield gpm)  
electric  
(type power)
- (7) electric log no  
(yes or no)  
no  
(organization running log)
- (8) how well bottom plugged: Sand chert  
back wash valve

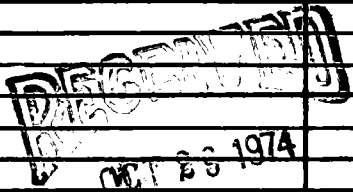

DRILLERS REMARKS:

MISS. BD. OF WATER COMM

If well telescopes please sketch and show depths.

GROUND LEVEL

			X

SECTION *Blue*

Please indicate well location X.

ADDITIONAL INFORMATION

If more than one screen, show locations of each on sketch.