

Harrison
 L 416
 1-26-75

MISSISSIPPI
 BOARD OF WATER COMMISSIONERS
 416 North State Street
 Jackson, Mississippi 39201

CODED

WATER WELL DRILLERS LOG

8-26-75 date well completed
 MB Drilling Co firm name
 Harrison county well located

LANDOWNER: JAY-JAY
Chevrolet
Paulsboro, Miss.
 (mailing address)

WELL LOCATION:
 sec. 8 T. 8 N. R. 11 E
2100 15 miles of CP
 (distance) (direction) (nearest town)


WELL PURPOSE: Water for tractor
 (home, irrigation, municipal, industrial)

WELL COMPLETION DATA:
 (1) diameter (inches) 4 X 2
 (2) total depth (feet) 440
 (3) static water level (feet) 18 below above top of ground
 (4) casing PVC Total (material) (depth)
4 X 2 If telescope see back. (size) 350 FT
 (5) screen 2-10 FT 39-5 FT (length) (depth to top)
2" PVC (size) (material)
 (6) pump 1/2 25 (HP) (yield gpm)
220V 16 (type power)
 (7) electric log No (yes or no)
 (organization running log)

description of formations encountered	from	to
Sand	0	35
Clay	35	40
Sand	40	75
Blue clay	75	150
Sand	150	250
Blue clay	250	393
Sand	393	418
Clay	418	435
Bottom	435	+

(8) how well bottom plugged
2" Bulb Valve

DRILLERS REMARKS:

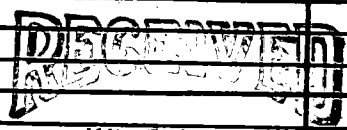

JUN 11 1975

MISS. BD. OF WATER COMM

