

420

Now Orange Grove Utilities Co  
Clarence Johnson

Harrison  
L 417  
7-20-74

MISSISSIPPI  
BOARD OF WATER COMMISSIONERS 7/21/80  
416 North State Street  
Jackson, Mississippi 39201

CODED

WATER WELL DRILLERS LOG  
COASTAL DRILLING & SERVICE CO.

7/20 1974 date well completed  
ROUTE 1 BOX 618 Harrison county well located

LANDOWNER: Kenneth Johnson

description of formations encountered  
BILCOA MMS. 39532

apt. min (mailing address)

WELL LOCATION:  
sec. 5 T 7 N R 11 E 135  
S W  
Orange Grove (distance) (direction) (nearest town)

description of formations encountered	from	to
Top Soil	1	3
Red Clay	3	15
fine sand	15	37
Shells	37	220
hard blue clay	220	229
Shells	229	260
fine white sand	260	290
hard blue clay	290	360
Shells	360	365
hard blue clay	365	420
fine white sand	420	438
fine white sand	438	528

WELL PURPOSE: Submersible  
(Domestic, Municipal, Industrial)


WELL COMPLETION DATA:

- (1) diameter (inches) 10 1/2
- (2) total depth (feet) 528'
- (3) static water level (feet) 30 below top of ground
- (4) casing Steel 468' (material) (depth)
- 10 1/2" If telescope see back.
- (5) screen 60' 468' (length) (depth to top)
- 6" SS (size) (material)
- (6) pump 25 500 (HP) (yield gpm)
- Ele (type power)
- (7) electric log no (yes or no)

(organization running log)

(8) how well bottom plugged  
6" crushed blue

DRILLERS REMARKS:

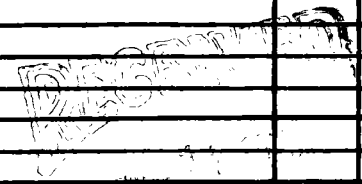

MISSISSIPPI BOARD OF WATER COMMISSIONERS

If well telescopes please sketch and show depths.

GROUND LEVEL

200 10" Still Pumping




268' 6" Casey  
~~20ft 1/2" Long Pipe~~

60' 6" S.S. Screen



5" Lock Wash Valve

If more than one screen, show locations of each on sketch.

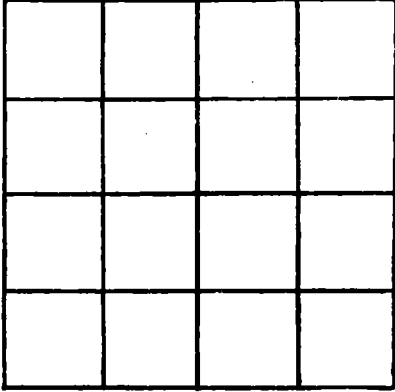

SECTION \_\_\_\_\_

Please indicate well location X.

ADDITIONAL INFORMATION

A Run good well

Horizontal lines for additional information.