

Harrison  
L 418  
3-25-74

MISSISSIPPI  
 BOARD OF WATER COMMISSIONERS  
 416 North State Street  
 Jackson, Mississippi 39201

CODED

WATER WELL DRILLERS LOG

3/25 1974 date well completed COASTAL DRILLING & SERVICE CO. county well located Harrison

LANDOWNER: Sheraton Motel  
Sgt. Davis  
 (mailing address)

WELL LOCATION:  
 sec. 17 T. 7 N. R. 11 E. 135  
11 miles N West of Sgt  
 (distance) (direction) (nearest town)

WELL PURPOSE: Motel Inn  
 (home, irrigation, municipal, industrial)

WELL COMPLETION DATA:  
 (1) diameter (inches) 10 1/2"  
 (2) total depth (feet) 842'  
 (3) static water level (feet) 23 below above top of ground.  
 (4) casing Steel 782'  
 (material) (depth)  
10 1/2" if telescope see back.  
 (5) screen 60' 782'  
 (length) (depth to top)  
6" SS  
 (size) (material)  
 (6) pump 15 225  
 (HP) (yield gpm)  
Ele  
 (type power)  
 (7) electric log 740  
 (yes or no)  
 (organization running log)

description of formations encountered	from	to
Top Soil	1	3
Red Clay	3	10
White Sand	10	25
Blue Gum bog	25	105
Hard Blue Clay	105	190
fine water sand	190	200
Coarse water sand	200	242
hard blue clay	242	440
Coarse water sand	440	480
Hard blue clay	480	570
fine water sand	570	608
Hard Blue Clay	608	740
dry cone with sand	740	842

(8) No. well bottom plugged 2  
Hand Wash Telee  
 DRILLERS REMARKS:


DEPARTMENT  
 JUL 17 1974

MISS. BD. OF WATER COMMISSIONERS

If well telescopes please sketch and show depths.

GROUND LEVEL

200 ft 10"  
Casing

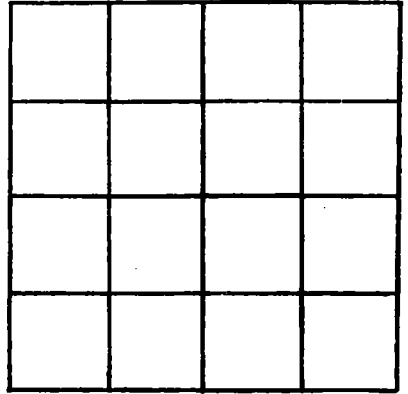

SECTION \_\_\_\_\_

Please indicate well location X.

ADDITIONAL INFORMATION

722' 6"  
Casing

20' 6" Long Pipe

60 ft 6" SS screen

6" Check/Walk Valve

If more than one screen,  
show locations of each on sketch.