

HARRISON
L419
3-20-81

MISSISSIPPI
BOARD OF WATER COMMISSIONERS
416 North State Street
Jackson, Mississippi 39201

CODED

WATER WELL DRILLERS LOG

BRADEN PUMP AND WELL SERVICE, INC.

HARRISON

3-20-81
date well completed

firm name

county well located

LANDOWNER: Bel AIR TRAILER PK

Darryl Dorsett Associates, Inc
16907 Mt. Citadel St.

South Valley, CA 92708
(mailing address)

WELL LOCATION:

sec. 15 T. 7 N. R. 11 E.
③ W
2 miles N of Gulfport
(distance) (direction) (nearest town)

WELL PURPOSE: TRAILER PARK
(home, irrigation, municipal, industrial)

WELL COMPLETION DATA:

- (1) diameter (inches) 6x4
- (2) total depth (feet) 560
- (3) static water level (feet) 33 ^{below}/_{above} top of ground.
- (4) casing PVC, total
(material) (depth)
6x4
(size) If telescope see back.
- (5) screen 30', 520'
(length) (depth to top)
4" stainless steel
(size) (material)
- (6) pump 10 170
(HP) (yield gpm)
230
(type power)
- (7) electric log NO
(yes or no)
(organization running log)


(8) how well bottom plugged
2" B.W. valve

DRILLERS REMARKS:
10' tail pipe

description of formations encountered

from to

Clay	0	120
SAND	120	155
Blue clay	155	340
SAND	340	362
Blue clay	362	420
SAND	420	550
CLAY	550	560

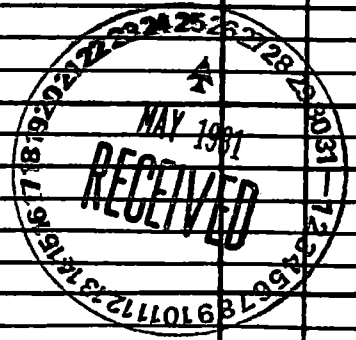

If well telescopes please sketch and show depths.

GROUND LEVEL

6" PVC
Sch 40

200

4" PVC
Sch 40

520

30" X 4"
stainless steel

550


560

	X		
11			

SECTION 15

Please indicate well location X.

ADDITIONAL INFORMATION

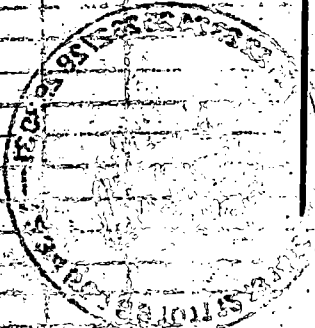

If more than one screen, show locations of each on sketch.