

Harrison
 L 423
 9-29-75

MISSISSIPPI
 BOARD OF WATER COMMISSIONERS
 416 North State Street
 Jackson, Mississippi 39201

WATER WELL DRILLERS LOG

September 29, 1975 LADNIEK Well Works Harrison
 date well completed firm name county well located


| LANDOWNER: | Description of formations encountered | from | to |
|--|---------------------------------------|------|-----|
| Greenwood | | | |
| Coleman Road | yellow clay | 0 | 20 |
| Landon Golfport, Miss | white sand | 20 | 40 |
| (mailing address) | blue clay | 40 | 465 |
| | blue sand | 465 | 525 |
| WELL LOCATION: | | | |
| sec. 2 T 7 S R 11 E | | | |
| 1/2 miles W of Landon | | | |
| (distance) (direction) (nearest town) | | | |
| WELL PURPOSE: home | | | |
| (home, irrigation, municipal, industrial) | | | |
| WELL COMPLETION DATA: | | | |
| (1) diameter (inches) 2" | | | |
| (2) total depth (feet) 525' | | | |
| (3) static water level (feet) 35' below top of ground. | | | |
| (4) casing gal. 43' (material) (depth) | | | |
| 1" If telescope see back. (size) | | | |
| (5) screen 20' 55" 505' (length) (depth to top) | | | |
| 2" gal. (size) (material) | | | |
| (6) pump 1 HP 10 (yield gpm) | | | |
| elec. (type power) | | | |
| (7) electric log NO (yes or no) | | | |
| (organization running log) | | | |
| (8) how well bottom plugged ballcheck | | | |
| DRILLERS REMARKS: | | | |

MISSISSIPPI
 BOARD OF WATER COMMISSIONERS
 15 OCT 23 1975

MISS. RD. UL WATER COLUMN

If well telescopes please sketch and show depths.

GROUND LEVEL

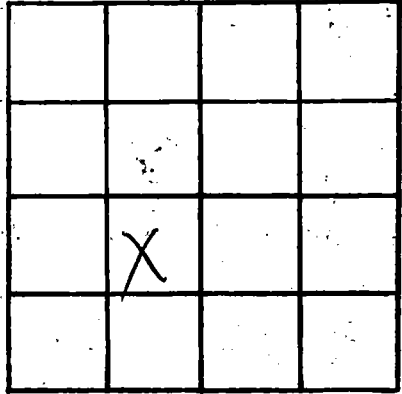

SECTION 2

Please indicate well location X.

ADDITIONAL INFORMATION

If more than one screen, show locations of each on sketch.