

HARRISON
L 442
5-28-79

MISSISSIPPI
BOARD OF WATER COMMISSIONERS
416 North State Street
Jackson, Mississippi 39201

CODED

WATER WELL DRILLERS LOG

COASTAL DRILLING & SERVICE CO.

5/28/79 19
date well completed

ROUTE 1 BOX 618
firm name county well located

BILOXI, MISS. 39532

LANDOWNER: *Flat Brook*

description of formations encountered

from to

Trade zone (Seyu)
apt 3 min
(mailing address)

<i>Top Soil</i>	1	3
<i>Red Clay</i>	3	15
<i>Comp. white Sand</i>	15	40
<i>Soft Blue Clay</i>	40	65
<i>Comp. white Sand</i>	65	120
<i>Soft Blue Clay</i>	120	230
<i>hard Blue Clay</i>	230	400
<i>hard Sand</i>	400	465
<i>fine white Sand</i>	465	510
<i>Base material</i>	510	540

WELL LOCATION:

sec. *16* T *2* N R *11* S W

London miles of (distance) (direction) (nearest town)

WELL PURPOSE: *water pit*
(home, irrigation, municipal, industrial)

WELL COMPLETION DATA:

- (1) diameter (inches) *4"*
- (2) total depth (feet) *540'*
- (3) static water level (feet) *40'* below top of ground.
- (4) casing *PDC* *525'*
(material) (depth)
- (size) If telescope see back.
- (5) screen *15'* *525'*
(length) (depth to top)
- 4"* *PDC*
(size) (material)
- (6) pump *2 hp* *40*
(HP) (yield gpm)
- 3 hp*
(type power)
- (7) electric log *no*
(yes or no)

(organization running log)

(8) how well bottom plugged

2nd backwash done

DRILLERS REMARKS: *19-B*


DEPT. OF NATURAL RESOURCES
BUREAU OF LAND & WATER RESOURCES

OCT 31 1980

RECEIVED

If well telescopes please sketch and show depths.

GROUND LEVEL

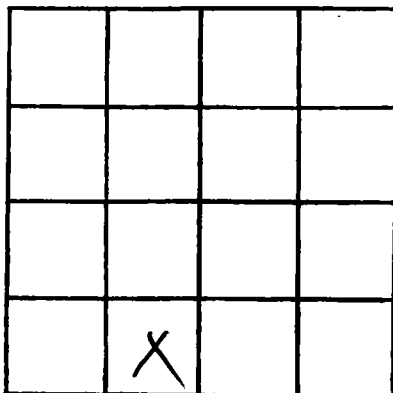

SECTION _____

Please indicate well location X.

ADDITIONAL INFORMATION

If more than one screen,
show locations of each on sketch.