

MISSISSIPPI DEPARTMENT OF NATURAL RESOURCES

Bureau of Land and Water Resources

Southport Mall

P.O. Box 10631

Jackson, Mississippi 39209

WATER WELL DRILLERS LOG

COASTAL DRILLING & SERVICE CO.

CODED

HARRISON  
L445  
10-18-79

10/18/79  
date well completed

ROUTE 1 BOX 618

Harrison  
county well located

BILOXI, MISS 39532

LANDOWNER: James C. ...  
Johnson Rd  
4pt, Miss  
(mailing address)

description of formations encountered

from to

Top Soil	13	
Red Clay	3	18
Sugar Sand	18	35
Coarse white Sand	35	75
Soft Blue Clay	75	210
fine water Sand	210	245
hard Blue Clay	245	290
fine water Sand	490	520
Coarse water Sand	520	550

WELL LOCATION:  
sec. 6 T 7 N R 11 W  
(2) 1/2 miles NW of Jordan  
(distance) (direction) (nearest town)

WELL PURPOSE: home  
(home, irrigation, municipal, industrial)

- WELL COMPLETION DATA:
- (1) diameter (inches) 4 1/2"
  - (2) total depth (feet) 550'
  - (3) static water level (feet) 70' below above top of ground
  - (4) casing PVC 535'  
(material) (depth)  
4 1/2" If telescope see back.  
(size)
  - (5) screen 15' 535'  
(length) (depth to top)  
2" PVC  
(size) (material)
  - (6) pump 1/2 25  
(HP) (yield gpm)  
Ele  
(type power)
  - (7) electric log no  
(yes or no)
- (organization running log)

DEPT. OF NATURAL RESOURCES  
BUREAU OF LAND & WATER RESOURCES

NOV - 3 1980

RECEIVED

(8) how well bottom plugged  
2" hard water table  
DRILLERS REMARKS: 19-B

If well telescopes please sketch and show depths.

GROUND LEVEL

200' 4" Pit Casing


335' 2" Pit Casing

15' 2" Pit Screen

2" back wash valve

19-B

If more than one screen, show locations of each on sketch.

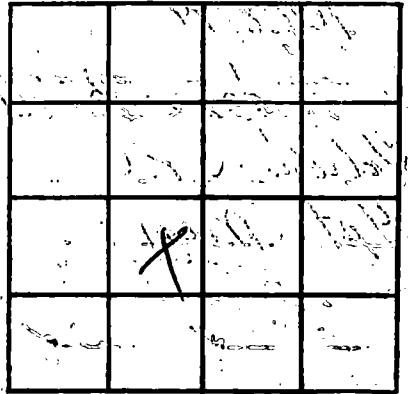

SECTION

Please indicate well location X.

ADDITIONAL INFORMATION

Additional information section with multiple horizontal lines for notes.