

MISSISSIPPI DEPARTMENT OF NATURAL RESOURCES

Bureau of Land and Water Resources

Southport Mall

P.O. Box 10631

Jackson, Mississippi 39209

WATER WELL DRILLERS LOG

COASTAL DRILLING & SERVICE CO.

CODED

HARRISON
L 446
9-5-79

ROUTE 4 Box 618

Harrison county well located

LANDOWNER: Gray Henderson

description of formations encountered

from

to

Coleman Rd
apt 101
(mailing address)

<u>top soil</u>	<u>1</u>	<u>3</u>
<u>red clay</u>	<u>3</u>	<u>15</u>
<u>red + white clay</u>	<u>15</u>	<u>35</u>
<u>coarse white sand</u>	<u>35</u>	<u>70</u>
<u>soft blue clay</u>	<u>70</u>	<u>210</u>
<u>fine water sand</u>	<u>210</u>	<u>230</u>
<u>soft blue clay</u>	<u>230</u>	<u>300</u>
<u>fine water sand</u>	<u>300</u>	<u>320</u>
<u>hard blue clay</u>	<u>320</u>	<u>510</u>
<u>fine water sand</u>	<u>510</u>	<u>520</u>
<u>good water sand</u>	<u>520</u>	<u>572</u>

WELL LOCATION:

sec 8 T 7 N R 11 E
S W
1/2 miles of None West London
(distance) (direction) (nearest town)

WELL PURPOSE:

(home, irrigation, municipal, industrial) home

WELL COMPLETION DATA:

- diameter (inches) 4 1/2"
- total depth (feet) 572'
- static water level (feet) 35' below above top of ground.
- casing 4 1/2" (material) 557' (depth)
4 1/2" (size) if telescope see back.
- screen 15' (length) 557' (depth to top)
2" (size) PVC (material)
- pump one (HP) 20 (yield gpm)
ele (type power)
- electric log no (yes or no)

(organization running log)

(8) how well bottom plugged

2" back wash valve

DRILLERS REMARKS: 19-B

DEPT. OF NATURAL RESOURCES
BUREAU OF LAND & WATER RESOURCES

NOV - 3 1980

RECEIVED

If well telescopes please sketch and show depths.

GROUND LEVEL


160' 4" PU Casing

397' 2" PU Casing

15' 2" PU Screen

2" backwash Valve
19-B

If more than one screen, show locations of each on sketch.

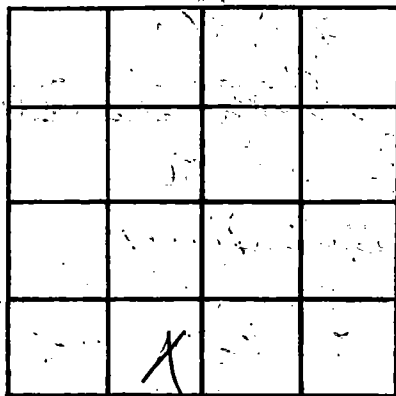

SECTION _____

Please indicate well location X.

ADDITIONAL INFORMATION

Lined area for additional information.