

MISSISSIPPI DEPARTMENT OF NATURAL RESOURCES

Bureau of Land and Water Resources

Southport Mall

P.O. Box 10631

Jackson, Mississippi 39209

WATER WELL DRILLERS LOG

39300
CODED

HARRISON
L451
06-04-82

6-4-82 date well completed 1982 Broden Pump & Well Dr. Harrison firm name Harrison county well located

LANDOWNER:
Acadian Village Condo.
West Beach - Gulfport.
(mailing address)

description of formations encountered	from	to
Sand	0	50
Clay	50	110
Sand	110	140

WELL LOCATION:
sec. 8 T. 8 N R. 11 E
In miles S of Eastport (nearest town)

WELL PURPOSE: Sprinkler
(home, irrigation, municipal, industrial)

WELL COMPLETION DATA:

(1) diameter (inches) 4

(2) total depth (feet) 140

(3) static water level (feet) 12 below top of ground

(4) casing PVC, 120 (material) (depth)
4" (size) If telescope see back.

(5) screen 20, 120 (length) (depth to top)
4" (size), PVC, 010 (material)

(6) pump 5 (HP) 100 (yield gpm)
230V 1Ø (type power)

(7) electric log No (yes or no)

(organization running log)

Elevation: 20 Feet

0890633302149

CODED

DEPT. OF NATURAL RESOURCES
BUREAU OF LAND & WATER RESOURCES


(8) how well bottom plugged
2 1/2 Sand Shock

DRILLERS REMARKS:

JUN 28 1982
RECEIVED

If well telescopes please sketch and show depths.

GROUND LEVEL

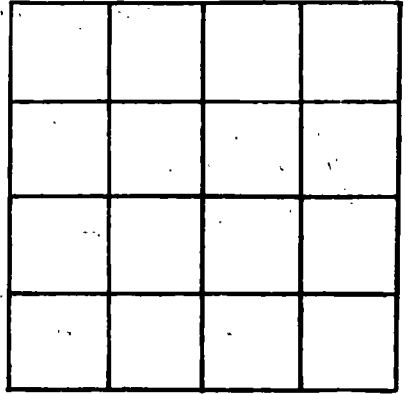

SECTION 2

Please indicate well location X.

ADDITIONAL INFORMATION

If more than one screen,
show locations of each on sketch.