

MISSISSIPPI DEPARTMENT OF NATURAL RESOURCES

Bureau of Land and Water Resources

Southport Mall

P.O. Box 10631

CODED

Jackson, Mississippi 39209

WATER WELL DRILLERS LOG

L 453
HARRISON
7-9-83

7/9 1983 Braden Pump & Well Serv. Harrison
 date well completed firm name county well located

LANDOWNER: Herbert Jay
Orange Grove Road
Southport, Ms. 39503
 (mailing address)

description of formations encountered	from	to
red clay	0	20
red-white clay	20	40
sand	40	60
sand + clay	60	80
white clay	80	120
blue clay	120	220
sand	220	295
blue clay	295	400
sand + clay	400	420
clay	420	500
sand	500	570
clay	570	575
sand	575	600
clay	600	620

WELL LOCATION:
 sec. 7 T. 7 N. R. 11 E.
1/2 miles N of London
 (distance) (direction) (nearest town)

WELL PURPOSE: home
 (home, irrigation, municipal, industrial)

WELL COMPLETION DATA:

- (1) diameter (inches) 2" x 4"
- (2) total depth (feet) 620
- (3) static water level (feet) 45 below top of ground.
- (4) casing PVC, 580' (material), (depth)
4"x2" if telescope see back. (size)
- (5) screen 10', 580' (length), (depth to top)
2", PVC underbar (size), (material)
- (6) pump 1/2 Subm 20 (HP), (yield gpm)
220 V 1 Ø (type power)
- (7) electric log no (yes or no)
 (organization running log)
- (8) how well bottom plugged PVC
sand shark

DRILLERS REMARKS: 30 ft
tail pipe.

CODED

DEPT. OF NATURAL RESOURCES
 BUREAU OF LAND & WATER RESOURCES

JUL 18 1983

RECEIVED

If well telescopes please sketch and show depths.


GROUND LEVEL

200' - 4" PVC

380' - 2" PVC

10' PVC
screen

30' telescopes

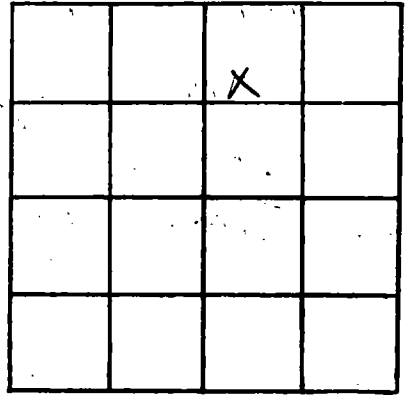

SECTION A

Please indicate well location X.

ADDITIONAL INFORMATION

If more than one screen, show locations of each on sketch.