

MISSISSIPPI DEPARTMENT OF NATURAL RESOURCES

Bureau of Land and Water Resources

Southport Mall

P.O. Box 10631

Jackson, Mississippi 39209

WATER WELL DRILLERS LOG

CODED

L454  
 HARRISON  
 7-2-83

7-2 1983 BRADEN Pump well HARRISON  
 date well completed firm name county well located

JERDIE, INC.

LANDOWNER: EDWARD BAKER  
 4650 - 5th Ave N.  
 St. Petersburg, FL. 33713  
 (mailing address)

description of formations encountered

from to

WELL LOCATION:  
 sec. 1 T 7 N R 10 E  
 S W  
 2 miles N.W. of DIBERVILLE  
 (distance) (direction) (nearest town)

SAND	0	40
CLAY (white)	40	60
CLAY (Blue)	60	100
SAND	100	120
CLAY (BLUE)	120	220
SAND	220	230
CLAY	230	280
SAND	280	310
CLAY	310	320

WELL PURPOSE: CAMP  
 (home, irrigation, municipal, industrial)

WELL COMPLETION DATA:

- (1) diameter (inches) 4 X 2
- (2) total depth (feet) 330
- (3) static water level (feet) 10 below top of ground
- (4) casing PVC 300 (material), (depth)  
 4 X 2 (size) If telescope see back.
- (5) screen 10' 300 (length), (depth to top)  
 2" PVC Underbar (size), (material)
- (6) pump 1/2 Subm. 20 (HP), (yield gpm)  
 220 (type power)
- (7) electric log No (yes or no)

CODED

(organization running log)

(8) how well bottom plugged BACKWASH VALVE

DEPT. OF NATURAL RESOURCES  
 BUREAU OF LAND & WATER RESOURCES

JUL 18 1983

RECEIVED

DRILLERS REMARKS:

10 FT. Tail pipe

If well telescopes please sketch and show depths.

GROUND LEVEL

120'  
4"

4x4  
PVC


4x2 PVC  
Bushing

180'  
2"

4x4  
PVC

(PVC)  
10 FT STRAINER  
BACK WASH  
VALVE

10 FT  
TAILPIPE

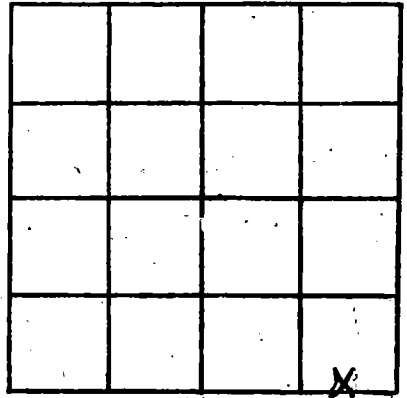

SECTION /

Please indicate well location X.

ADDITIONAL INFORMATION

If more than one screen, show locations of each on sketch.