

HAR. MISSISSIPPI BOARD OF WATER COMMISSIONERS

L455
7-30-60

WATER WELL DRILLERS LOG CODED

Date: 7-30, 1960, Driller: Sutter Well Works County Harrison

(Name)

(1) Owner of Land: V. A. Anderson
(Name)

Gueffert, Miss.
(Address)

(2) Location: 1/4, 26 87 1/2 Sec. 7 R. 11 E.

miles of
(distance) (direction) (Nearest Town)

(3) Topography: flat
(Hilly) (Flat) (Level)

(4) Purpose of Well: domestic
(Domestic Irrigation
Municipal, Industrial, Other)

Description & Color of Materials
Sand, Clay, Red Clay, Shell, etc.

Thick-
ness
Feet

Depth
Feet

brown sand

30 30

mixed sand & mud

82 112

blue clay

181 293

sand

42 335

CODED

Information upon completion of well:

(1) Diameter 4 inches.

(2) Total Depth 335 feet.

(3) Water Level 4 feet below top of ground.

(4) Cased to all, Size 4"

(5) Screen: Size 4", Length 20'


(6) Were any formations sealed against pollution?

yes, no. ✓

If YES depth of formation

Why

Drillers Remarks:

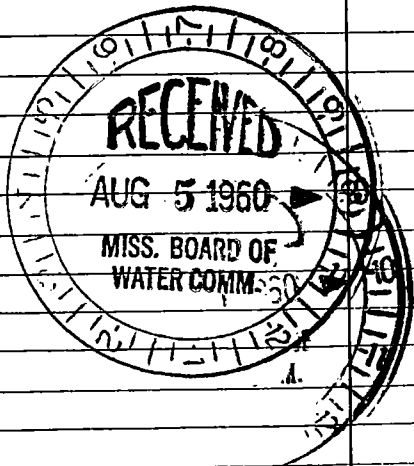

(Use Back Side)

Well No.

