

HAR.

L 456

9-2-60

CODED

K-304

WATER WELL DRILLERS LOG

Date: Sept 2, 1960, Driller: C.T. Switzer Well Co. County Harrison  
(Name)

(1) Owner of Land: Mrs. Ruby L. Dubois  
Rt. 1 Box 491 Gulfport on London Rd.  
3 miles W. of Junction with Highway 90  
(Address)

(2) Location: 1/4, 1/4, Sec. 7 + 3 T. R. 11  
3 1/2 miles N, of Gulfport  
(distance) (direction) (Nearest Town)

(3) Topography:  (Hilly)  (Flat)  (Level)

(4) Purpose of Well: domestic  
(Domestic Irrigation, Municipal, Industrial, Other)

Description & Color of Materials Sand, Clay, Red Clay, Shell, etc.	Thick- ness Feet	Depth Feet
Clay	0	81
sand	81	89
Clay	89	144
sand	144	149
Clay	149	182
good sand	182	236

Information upon completion of well:

(1) Diameter 2 inches.

(2) Total Depth 236 feet.

(3) Water Level -22' feet below top of ground.

(4) Cased to 236', Size 2"


(5) Screen: Size 2", Length 10' 8 1/2"

(6) Were any formations sealed against pollution?  
 yes,  no.

If YES depth of formation 10 feet  
 Why Health dept. requirements

Drillers Remarks:

CODED

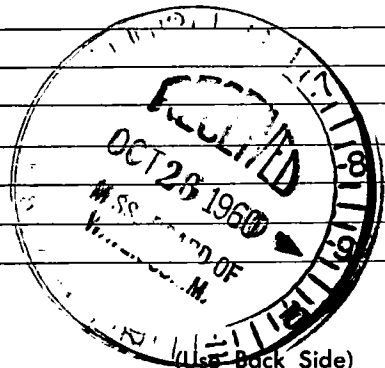

Well No.

