

L457
11-19-62

WATER WELL DRILLERS LOG

CODED

Date: 11-19, 1962, Driller: C. T. SWITZER WELL CO County: Harrison
(Name)

(1) Owner of Land: Louis Wood
(Name)
30th St. Blueport
(Address)

(2) Location: NW 1/4, NW 1/4, Sec. 4 T5 R14
_____ miles _____ of _____
(distance) (direction) (Nearest Town)

(3) Topography: Flat
(Hilly) (Flat) (Level)

(4) Purpose of Well: Hand house
(Domestic Irrigation, Municipal, Industrial, Other)

Description & Color of Materials Sand, Clay, Red Clay, Shell, etc.	Thick- ness Feet	Depth Feet
Clay	00	34
Sand	34	105
Sand & gravel	105	125
Clay	125	260
Shell	260	290
Clay	290	306
Clay & shell	306	344
Clay & sand shls	344	366
Clay	366	494
Sand, fine	494	508
Clay	508	548
Sand	548	556
Clay	556	610
Clay & shell	610	630
Clay	630	730
Sand	730	738
Clay	738	758
Sand, shls	758	770
Sand	770	785

Information upon completion of well:

(1) Diameter 4" inches.

(2) Total Depth 885' feet.

(3) Water Level 59' feet below top of ground.

(4) Cased to 885', Size 4"

(5) Screen: Size 4", Length 30'


(6) Were any formations sealed against pollution?
✓ yes, _____ no.

CODED

If YES depth of formation _____

Why health dept. requirements

Drillers Remarks: _____

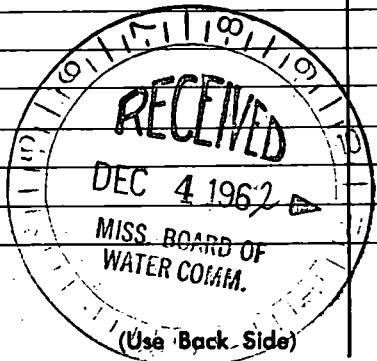

Well No.

