

MISSISSIPPI BOARD OF WATER COMMISSIONERS

HAR.

L 460

9-13-62

WATER WELL DRILLERS LOG CODED

Date: 9-13, 1962, Driller: Sutton Well Works County Harrison

(Name)

- (1) Owner of Land: Mechanics Refrig.
 (Name)
Shuffart, Miss.
 (Address)
- (2) Location: 7 1/2 AA R
7 1/2 miles IN of Shuffart
 (distance) (direction) (Nearest Town)
- (3) Topography: flat
 (Hilly) (Flat) (Level)
- (4) Purpose of Well: Industrial
 (Domestic Irrigation
 Municipal, Industrial, Other)


Description & Color of Materials Sand, Clay, Red Clay, Shell, etc.	Thick-ness Feet	Depth Feet
<u>Sand</u>	<u>35</u>	<u>35</u>
<u>Clay</u>	<u>195</u>	<u>230</u>
<u>sand</u>	<u>22</u>	<u>252</u>
<u>Clay</u>	<u>32</u>	<u>284</u>
<u>sand</u>	<u>35</u>	<u>319</u>

Information upon completion of well:

- (1) Diameter 2 inches.
- (2) Total Depth 319 feet.
- (3) Water Level 22 feet below top of ground.
TOP 67' - 2 1/2"
- (4) Cased to all, Size 2"
- (5) Screen: Size 2", Length 10'
- (6) Were any formations sealed against pollution?
no ✓

CODED

If YES depth of formation _____
 Why _____
 Drillers Remarks: _____

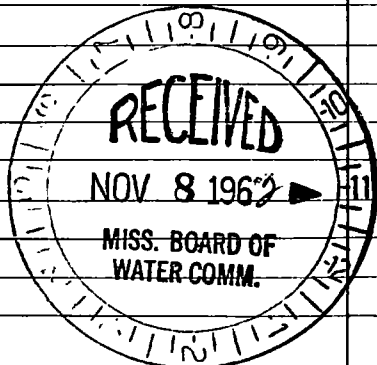

(Use Back Side)

Well No.

