

HAR. MISSISSIPPI BOARD OF WATER COMMISSIONERS

L 461  
11-9-62

WATER WELL DRILLERS LOG

CODED

C. T. SWITZER WELL CO.

Date: 11-9, 1962, Driller: \_\_\_\_\_ County: Harrison

(Name)

(1) Owner of Land: William A. Allen  
(Name)  
Allen Road  
(Address)  
 Rt 1, Box 518A, Sulphur

(2) Location: 1/4, 14 Sec. 7 31  
(distance) (direction) (Nearest Town)  
\_\_\_\_\_ miles \_\_\_\_\_ of \_\_\_\_\_  
(distance) (direction) (Nearest Town)

(3) Topography:  (Hilly)  (Flat)  (Level)

(4) Purpose of Well: Domestic  
(Domestic Irrigation  
 Municipal, Industrial, Other)

Description & Color of Materials Sand, Clay, Red Clay, Shell, etc.	Thick- ness Feet	Depth Feet
Clay	00	16
Sand	16	32
Clay	34	66
Sand, fair	160	180
Sand, good	180	228

Information upon completion of well:

(1) Diameter 2 inches.

(2) Total Depth 228 feet.

(3) Water Level 32' feet below top of ground.

(4) Cased to 229', Size 2"

(5) Screen: Size 2", Length 10'


(6) Were any formations sealed against pollution?  
 yes,  no.

CODED

If YES depth of formation \_\_\_\_\_

Why Health department requirements

Drillers Remarks: \_\_\_\_\_

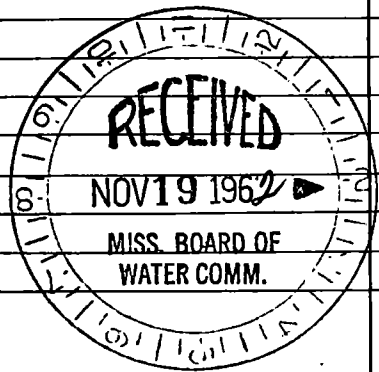

(Use Back Side)

Well No.

*[The page contains extremely faint and illegible text, likely bleed-through from the reverse side of the document. The text is scattered across the page and does not form any recognizable words or sentences.]*