

MISSISSIPPI BOARD OF WATER COMMISSIONERS

HAR.

L 463

12-12-62

N 539 401

WATER WELL DRILLERS LOG

C. I. SWITZER WELL CO.

CODED

Date: 12-12, 1962, Driller: _____ County: Harrison
(Name)

(1) Owner of Land: Frank W. Taylor
(Name)
Red Creek Road, Mulport
(Address)

(2) Location: 1/4, 23 47R 17R
Sec. _____
_____ miles _____ of _____
(distance) (direction) (Nearest Town)

(3) Topography: (Hilly) (Flat) (Level)

(4) Purpose of Well: Domestic
(Domestic Irrigation
Municipal, Industrial, Other)

Description & Color of Materials Sand, Clay, Red Clay, Shell, etc.	Thick- ness Feet	Depth Feet
Clay	00	15
Sand	15	20
Sand, good	20	40
Sand & pea gravel	40	60
Clay	60	90
Sand	90	103
Clay	103	155
Sand	155	160
Sand, dry	160	210
Clay	210	400
Sand, fine	400	440
Clay	440	490
Sand, red good	490	500
Clay	500	520
Sand, good	520	570

Information upon completion of well:

(1) Diameter: 2 inches.

(2) Total Depth: 570 feet.

(3) Water Level: top of good feet below top of ground.

(4) Cased to: 570', Size: 2"

(5) Screen: Size: 2", Length: 10'


(6) Were any formations sealed against pollution?
 yes, no.

CODED

If YES depth of formation _____

Why: State Dept. Requirements

Drillers Remarks: _____

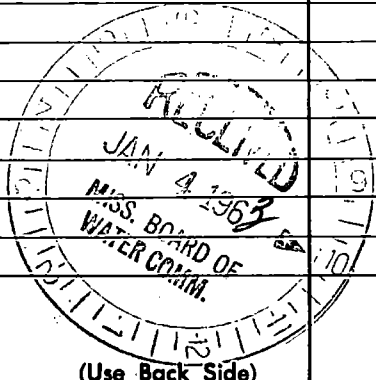

(Use Back Side)

Well No.

Ad. 11-11

10 11
11 12
12 13
13 14
14 15
15 16
16 17
17 18
18 19
19 20
20 21
21 22
22 23
23 24
24 25
25 26
26 27
27 28
28 29
29 30
30 31

[Faint, illegible handwritten text]

750

[Faint, illegible handwritten text]

11-11