

HAR.  
L 464  
4-27-63

D 114 09  
WATER WELL DRILLERS LOG

CODED

Date: 4-27, 1963, Driller: SWITZER County: Harrison

(Name)

(1) Owner of Land: Dr. R. J. Ritter  
(Name)  
939 1st St. Memphis  
(Address)

(2) Location: 1/4, 1/4, Sec. T. R.  
33 7 40  
miles of (distance) (direction) (Nearest Town)

(3) Topography: (Hilly) (Flat) (Level)

(4) Purpose of Well: Domestic  
(Domestic Irrigation Municipal, Industrial, Other)

Description & Color of Materials Sand, Clay, Red Clay, Shell, etc.	Thick- ness Feet	Depth Feet
Sand	10	30
Clay	10	40
Sand	10	50
Sand, good	10	60
		75


Information upon completion of well:

- (1) Diameter 2 inches.
- (2) Total Depth 75 feet.
- (3) Water Level 19' feet below top of ground.
- (4) Cased to 45', Size 2"
- (5) Screen: Size 2", Length 10'
- (6) Were any formations sealed against pollution?  
 yes,  no.

If YES depth of formation \_\_\_\_\_  
Why Health Dept. requirement

Drillers Remarks:

CODED

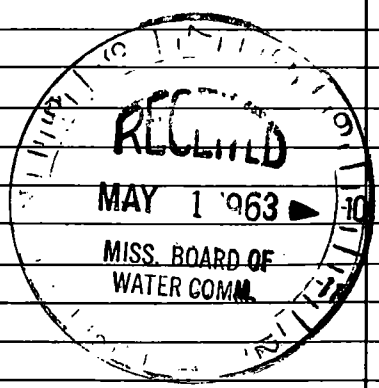

Well No.

(Use Back Side)

1900