

HAR.
L 465
8-1-64

M 525704
S 170205
WATER WELL DRILLERS LOG

CODED

Date: Aug 1, 1964, Driller: C. T. SWITZER WELL CO County Harrison
(Name)

(1) Owner of Land: R. W. Richardson
(Name)

902- 2nd St Gulfport
(Address) Miss

(2) Location: 1/4, 1/4, Sec. T R
26 of (K 7 1/2)
(distance) (direction) (Nearest Town)

(3) Topography: (Hilly) (Flat) (Level)

(4) Purpose of Well: domestic
(Domestic Irrigation, Municipal, Industrial, Other)

Description & Color of Materials Sand, Clay, Red Clay, Shell, etc.	Thick- ness Feet	Depth Feet
<u>Sand</u>	<u>00</u>	<u>41</u>
<u>Clay</u>	<u>41</u>	<u>156</u>
<u>Clay + sand sibs</u>	<u>156</u>	<u>179</u>
<u>Clay</u>	<u>179</u>	<u>183</u>
<u>Sand</u>	<u>183</u>	<u>189</u>
<u>Clay</u>	<u>189</u>	<u>263</u>
<u>Sand</u>	<u>263</u>	<u>277</u>
<u>Clay</u>	<u>277</u>	<u>292</u>
<u>Sand</u>	<u>292</u>	<u>326</u>
<u>Sand, gravel</u>	<u>326</u>	<u>334</u>

Information upon completion of well:

(1) Diameter 3 1/2 inches.

(2) Total Depth 334 feet.

(3) Water Level 8'6" feet below top of ground.

(4) Cased to 334, Size 3X2'


(5) Screen: Size 2", Length 15'

(6) Were any formations sealed against pollution?
X yes, no.

If YES depth of formation _____

Why Health Dept Requirements

Drillers Remarks: _____

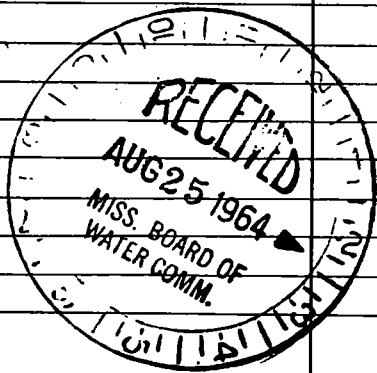

Well No.

(Use Back Side)

