

HAR.

MISSISSIPPI BOARD OF WATER COMMISSIONERS

L 466

W 110411

CODED

10-29-65

WATER WELL DRILLERS LOG

Date: 10-29, 1965, Driller: Sutter Well Works County Harrison

(Name)

(1) Owner of Land: Mrs. Clay Reeves (Name)

2214 Beach Ave. Moss City, Miss. (Address)

(2) Location: 1/4, 1/4, Sec. 7, T10R

miles 1.0, or 10, of Gulfport (distance) (direction) (Nearest Town)

(3) Topography: flat (Hilly) (Flat) (Level)

(4) Purpose of Well: domestic (Domestic Irrigation, Municipal, Industrial, Other)

Description & Color of Materials Sand, Clay, Red Clay, Shell, etc.

Thick-ness Feet

Depth Feet

Sand 29 29
Clay - sand streaks 33 2 361
fine sand 13 374
sand 18 392

CODED

Information upon completion of well:

(1) Diameter 4x2 inches.

(2) Total Depth 392 feet.

(3) Water Level 9 feet below top of ground.

(4) Cased to all top 84' of 4" Size B&L 3"

(5) Screen: Size 2", Length 15'


(6) Were any formations sealed against pollution?

yes, no.

If YES depth of formation

Why

Drillers Remarks:

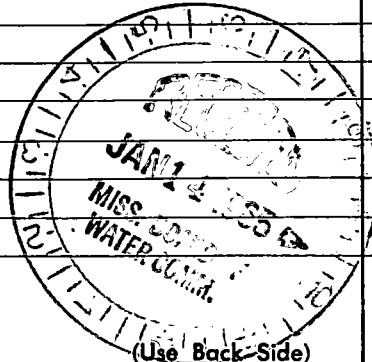

Well No.

(Use Back Side)

Handwritten text at the top of the page, possibly a title or header.

Handwritten text, possibly a date or a specific reference.

Handwritten text on the left side of the page.

Handwritten text on the right side of the page.

Handwritten text in the middle-right section of the page.

Handwritten text in the lower-middle section of the page.

Handwritten text in the lower-right section of the page.

Large block of handwritten text at the bottom of the page.

