

Harrison
 L ~~46~~ 467
 4-24-74

MISSISSIPPI
 BOARD OF WATER COMMISSIONERS
 416 North State Street
 Jackson, Mississippi 39201



WATER WELL DRILLERS LOG

CODED

4/24 1974 COASTAL DRILLING & SERVICE CO. Harrison
 date well completed firm name county well located
 ROUTE 1 BOX 618

LANDOWNER	description of formations encountered	from	to
P.O. 1508	Top Soil	1	3
Lat. Morris (mailing address)	Red Clay	3	15
	White Sand	15	36
	Soft Blue Clay	36	200
	Hard Blue Clay	200	240
	fine water sand	240	240
	fine water sand	260	290

WELL LOCATION:
 sec. 18 T 7 N R 11 E 135
 S W
 2 1/2 miles W Jordan
 (distance) (direction) (nearest town)

WELL PURPOSE: Industrial
 (home, irrigation, municipal, industrial)

WELL COMPLETION DATA: "

(1) diameter (inches) 2x4"

(2) total depth (feet) 290'

(3) static water level (feet) 20' below above top of ground.

(4) casing PVC, 275' (material) (depth)
 5'x4" (size) If telescope see back.

(5) screen 15' 275' (length) (depth to top)
 15' PVC (size) (material)

(6) pump One 20 (HP) (yield gpm)
 Ele (type power)

(7) electric log no (yes or no)

(organization running log)

CODED

(8) how well bottom plugged
 20' (handwritten note)

DRILLERS REMARKS:

REGISTERED
 JUL 17 1975

If well telescopes please sketch and show depths.

GROUND LEVEL


200' 4" PVC

75 ft 2" PVC

15 ft 2" PVC
Screen

2" backwash Valve

If more than one screen,
show locations of each on sketch.

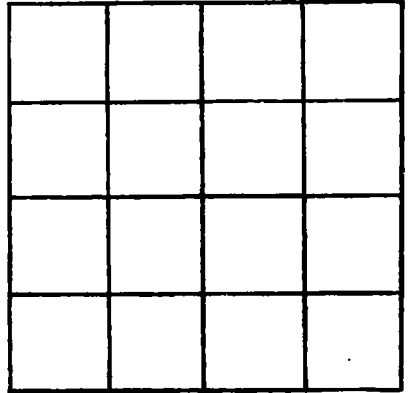

SECTION _____

Please indicate well location X.

ADDITIONAL INFORMATION

Multiple horizontal lines for additional information.