

Harrison  
 L 432 469  
 5-11-74

MISSISSIPPI  
 BOARD OF WATER COMMISSIONERS  
 416 North State Street  
 Jackson, Mississippi 39201

CODED

CODED

WATER WELL DRILLERS LOG  
 COASTAL DRILLING & SERVICE CO.

5/11 1974 date well completed ROUTE 1 BOX 618 Harrison county well located

LANDOWNER: A E Spearman  
 Rt 5 Box 1048  
 Apt 5 min  
 (mailing address)

BILOXI, MISS 39552

description of formations encountered	from	to
Top Soil	1	3
Red Clay	3	15
White Sand	15	45
gray clay	45	78
light white sand	78	100
hard blue clay	100	210
white sand fine	210	218
hard blue clay	218	260
fine white sand	260	265
Coarse white sand	265	290

WELL LOCATION:  
 sec 12 T 7 N R 11 S 135  
 (distance) (direction) (nearest town)

WELL PURPOSE: Home  
 (home, irrigation, municipal, industrial)


WELL COMPLETION DATA:

- (1) diameter (inches) 2"
- (2) total depth (feet) 290
- (3) static water level (feet) 35 below top of ground
- (4) casing PVC 280 (material), (depth)
- (size) If telescope see back.
- (5) screen 10' 280 (length), (depth to top)
- 2" PVC (size), (material)
- (6) pump (HP) (yield gpm)
- (type power)
- (7) electric log no (yes or no)
- (organization running log)

CODED

(8) how well bottom plugged  
 2" horizontal holes

DRILLERS REMARKS:

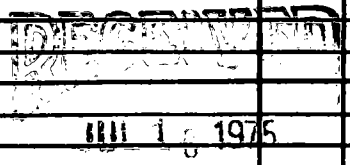

If well telescopes please sketch and show depths.

GROUND LEVEL


SECTION \_\_\_\_\_

Please indicate well location X.

ADDITIONAL INFORMATION

If more than one screen, show locations of each on sketch.