

L ~~H~~ 471  
 Harrison  
 12/11/74

MISSISSIPPI  
 BOARD OF WATER COMMISSIONERS  
 416 North State Street  
 Jackson, Mississippi 39201

~~CODED~~

CODED

WATER WELL DRILLERS LOG

Dec 11 1974 LADNIEF'S WELL WORKS HARRISON  
 date well completed firm name county well located

LANDOWNER: TAKE BELL  
 OLD HIGHWAY 49  
 Gulfport MS 39501  
 (mailing address)

description of formations encountered	from	to
yellow sand + clay	0	65
blue clay	65	375
blue sand	375	390

WELL LOCATION:  
 sec. 2 T 7 S R 11 W  
 1/2 miles N of Gulfport  
 (distance) (direction) (nearest town)

WELL PURPOSE: HOME  
 (home, irrigation, municipal, industrial)

CODED

- WELL COMPLETION DATA:
- diameter (inches) 2 in.
  - total depth (feet) 390 ft.
  - static water level (feet) 6 ft below top of ground.
  - casing plastic, 380 ft.  
 (material) (depth)  
 (size) if telescope see back.
  - screen 10 ft., 380 ft.  
 (length) (depth to top)  
 2 in., plastic  
 (size) (material)
  - pump \_\_\_\_\_ (HP) \_\_\_\_\_ (yield gpm)  
 (type power)
  - electric log NO  
 (yes or no)  
 (organization running log)
  - how well bottom plugged ball check

REGISTERED  
 MAY 5 1975


DRILLERS REMARKS:

MISS. BD. OF

MM

If well telescopes please sketch and show depths.

GROUND LEVEL

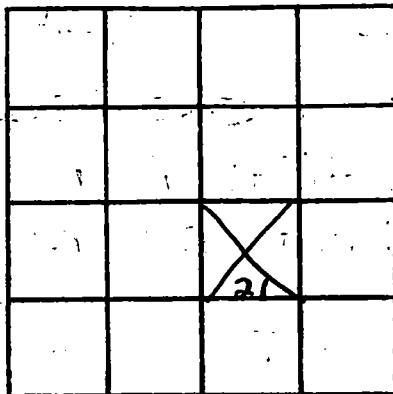

SECTION 2

Please indicate well location X.

ADDITIONAL INFORMATION

If more than one screen, show locations of each on sketch.