

Harrison
 L ~~472~~ 472
 6-30-75

MISSISSIPPI
 BOARD OF WATER COMMISSIONERS CODED
 416 North State Street
 Jackson, Mississippi 39201

WATER WELL DRILLERS LOG
 COASTAL DRILLING & SERVICE CO. *Harrison*
 ROUTE ~~1~~ ¹ BOX 618 county well located

6/30/75
 date well completed

LANDOWNER: *J.R. Williams*
Rt 5 Williams Rd
Hgt, Miss
 (mailing address)

WELL LOCATION: *13S*
 sec. *3* T. *7* N. R. *11* E
S *W*
2 1/2 miles *N* of *Jordan*
 (distance) (direction) (nearest town)

WELL PURPOSE: *Home*
 (home, irrigation, municipal, industrial)

- WELL COMPLETION DATA:
- (1) diameter (inches) *2"*
 - (2) total depth (feet) *500'*
 - (3) static water level (feet) *40* below above top of ground.
 - (4) casing *PVC* *5190'*
 (material) (depth)
 (size) if telescope see back.
 - (5) screen *10'* *490'*
 (length) (depth to top)
2" *PVC*
 (size) (material)
 - (6) pump *One* *11*
 (HP) (yield gpm)
Cl *set*
 (type power)
 - (7) electric log *Yes*
 (yes or no)
 (organization running log)

Description of Formations encountered	MISS. 39532	
	from	to
<i>top soil</i>	<i>1</i>	<i>3</i>
<i>Red Sand & clay</i>	<i>3</i>	<i>18</i>
<i>white sand</i>	<i>18</i>	<i>40</i>
<i>soft humks</i>	<i>40</i>	<i>125</i>
<i>fine sand</i>	<i>125</i>	<i>140</i>
<i>soft humks</i>	<i>140</i>	<i>260</i>
<i>hard clay</i>	<i>260</i>	<i>310</i>
<i>fine water sand</i>	<i>310</i>	<i>325</i>
<i>blue hard clay</i>	<i>325</i>	<i>420</i>
<i>fine water sand</i>	<i>420</i>	<i>440</i>
<i>course water sand</i>	<i>440</i>	<i>500</i>

CODED


(8) how well bottom plugged
2" bedrock shell

DRILLERS REMARKS:

MISS. BD. OF WATER COMMISSIONERS
 JUNE 17 1975

If well telescopes please sketch and show depths.

GROUND LEVEL

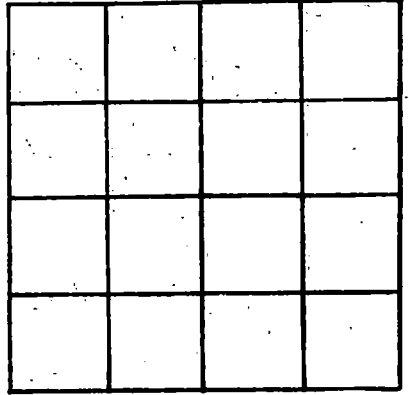

SECTION _____

Please indicate well location X.

ADDITIONAL INFORMATION

Lined area for additional information.

If more than one screen, show locations of each on sketch.