

HARRISON
L 476
11-6-75

MISSISSIPPI
 BOARD OF WATER COMMISSIONERS
 416 North State Street
 Jackson, Mississippi 39201

CODED

WATER WELL DRILLERS LOG

11/6 1975 COASTAL DRILLING & SERVICE CO. Harrison
 date well completed ROUTE # T BOX 618 county well located

LANDOWNER Carl Tyeget BILOXI, MISS. 39532
Lorraine Rd
Hgt, Min
 (mailing address)

Mississippi Formations encountered	from	to
<u>Top Soil</u>	<u>1</u>	<u>3</u>
<u>Red Clay</u>	<u>3</u>	<u>30</u>
<u>White Sand</u>	<u>30</u>	<u>75</u>
<u>Soft Blue Clay</u>	<u>75</u>	<u>200</u>
<u>fine water sand</u>	<u>200</u>	<u>230</u>
<u>Hard Blue Clay</u>	<u>230</u>	<u>460</u>
<u>fine water sand</u>	<u>460</u>	<u>480</u>
<u>Hard Blue Clay</u>	<u>480</u>	<u>540</u>
<u>fine water sand</u>	<u>540</u>	<u>565</u>
<u>Coarse water sand</u>	<u>565</u>	<u>605</u>

WELL LOCATION:
 sec 7 T 7 N R 11 E
2 1/2 miles NW of Landon
 (distance) (direction) (nearest town)


WELL PURPOSE: Home
 (home, irrigation, municipal, industrial)

- WELL COMPLETION DATA:
- (1) diameter (inches) 2"
 - (2) total depth (feet) 605'
 - (3) static water level (feet) 40 below top of ground.
 - (4) casing PVC, 590'
 (material) (depth)
 - _____ If telescope see back.
 (size)
 - (5) screen 15', 590'
 (length) (depth to top)
 - 2", PVC
 (size) (material)
 - (6) pump One, 14
 (HP) (yield gpm)
 - Elc
 (type power)
 - (7) electric log No
 (yes or no)
 - _____ (organization running log)

CODED

(8) how well bottom plugged 2nd hard sand value

DRILLERS REMARKS: None

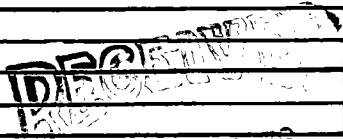

MISS. BD. OF WATER COMMISSIONERS

