

HARRISON
L 477
3/22/76

MISSISSIPPI
BOARD OF WATER COMMISSIONERS
416 North State Street
Jackson, Mississippi 39201

CODED

WATER WELL DRILLERS LOG

3-22-1976 *McMill Well Works Inc. Harrison*
date well completed firm name county well located

LANDOWNER	description of formations encountered	from	to
<i>Jerry R. Anglin</i> <i>360' 17 st.</i>	<i>Sand</i>	<i>0</i>	<i>30</i>
<i>66, no.</i> (mailing address)			
WELL LOCATION:			
sec. <i>36</i> T <i>7</i> N R <i>11</i> E			
<i>1/2</i> miles <i>E</i> of <i>Deeph.</i>			
(distance) (direction) (nearest town)			
WELL PURPOSE: <i>Lawn</i> (home, irrigation, municipal, industrial)			
WELL COMPLETION DATA:			
(1) diameter (inches) <i>2 1/2</i>			
(2) total depth (feet) <i>30'</i>			
(3) static water level (feet) <i>2" below</i> above top of ground.			
(4) casing <i>plastic 20</i> (material) (depth)			
_____ if telescope see back. (size)			
(5) screen <i>10'</i> (length) (depth to top)			
<i>2"</i> (size) <i>plastic</i> (material)			
(6) pump <i>1/2</i> <i>12</i> (HP) (yield gpm)			
<i>electric</i> (type power)			
(7) electric log <i>no</i> (yes or no)			
_____ (organization running log)			
(8) how well bottom plugged <i>plugged</i>			
DRILLERS REMARKS:			

CODED


RECEIVED

JAN 20 1977

MISS. BD. OF WATER COMM

If well telescopes please sketch and show depths.

GROUND LEVEL

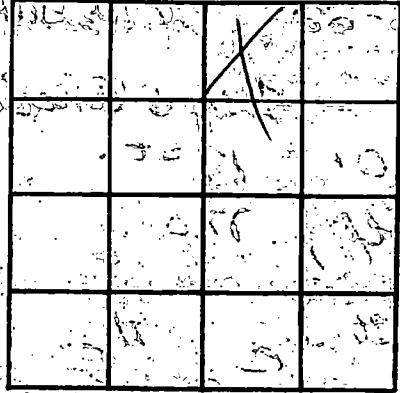

SECTION 36

Please indicate well location X.

ADDITIONAL INFORMATION

If more than one screen, show locations of each on sketch.