

Harrison
 L 480
 4-15-76

MISSISSIPPI
 BOARD OF WATER COMMISSIONERS
 416 North State Street
 Jackson, Mississippi 39201

CODED

WATER WELL DRILLERS LOG

4-15-1976 ¹³⁵ Mc Hill Well Works Inc. Harrison
 date well completed firm name county well located


LANDOWNER: William Brewer
Rt. 3, Box 687-A
Hill, Mo.
 (mailing address)
 WELL LOCATION:
 ? sec 19 T 7 N R 11 E
2 1/2 miles S.W. of Landon
 (distance) (direction) (nearest town)

description of formations encountered	from to	
sand	0	20
Blue clay	20	68
slush	68	137
Blue clay	137	183
course sand	183	210

WELL PURPOSE: None
 (home, irrigation, municipal, industrial)

WELL COMPLETION DATA:
 (1) diameter (inches) 2"
 (2) total depth (feet) 210
 (3) static water level (feet) 32' ^{below} _{above} top of ground.
 (4) casing PVC sch 40 200'
 (material) (depth)
 (size) if telescope see back.
 (5) screen 10'
 (length) (depth to top)
2" 3.5
 (size) (material)
 (6) pump 1 8
 (HP) (yield gpm)
Electric
 (type power)
 (7) electric log no
 (yes or no)
 (organization running log)
 (8) how well bottom plugged sand
shale

CODED

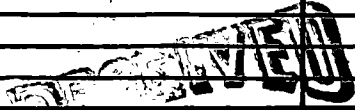


APR 20 1976

MISS. BO. OF WATER COMMISSIONERS

DRILLERS REMARKS:

If well telescopes please sketch and show depths.

GROUND LEVEL

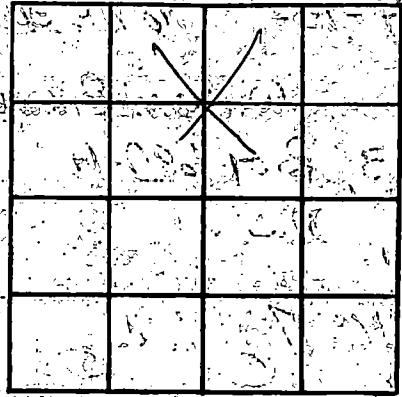

SECTION 19

Please indicate well location X.

ADDITIONAL INFORMATION

If more than one screen, show locations of each on sketch.