

HARRISON
 L 484
 4-24-76

MISSISSIPPI
 BOARD OF WATER COMMISSIONERS
 416 North State Street
 Jackson, Mississippi 39201

CODED

WATER WELL DRILLERS LOG

April 24 19 76 M&B Drilling Co. Harrison
 date well completed firm name county well located

LANDOWNER: Cordon Smith
P.R. London Rd -
Quitport, Miss.
 (mailing address)

WELL LOCATION:
 sec. 17 T 7 N R 11 E
3 miles N of Quitport
 (distance) (direction) (nearest town)

WELL PURPOSE: Home
 (home, irrigation, municipal, industrial)

- WELL COMPLETION DATA:
- (1) diameter (inches) 2
 - (2) total depth (feet) 410
 - (3) static water level (feet) 22 below top of ground
 - (4) casing PVC (material) Total (depth)
2" (size) If telescope see back.
 - (5) screen 10ft (length) 375 (depth to top)
2" (size) PVC (material)
 - (6) pump 1 (HP) 15 (yield gpm)
NOV 18 (type power)
 - (7) electric log No. (yes or no)


(organization running log)

(8) how well bottom plugged
2" Beach Wood Valve

DRILLERS REMARKS:

description of formations encountered	from	to
Clay	0	15
Cruff Clay	15	35
White Sand	35	50
White Clay	50	90
Blue Clay	90	145
Sand	145	152
Blue Clay	152	160
Sand	160	185
Blue Clay	185	200
One Sand	200	212
Blue Clay	212	215
Fine Grey Sand	215	225
Blue Clay	225	323
Coarse Grey Sand	323	385
Blue Clay	385	410+

CODED

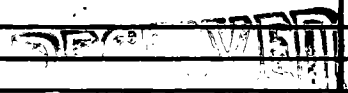

MAY 10 1976

MISSISSIPPI BOARD OF WATER COMMISSIONERS

If well telescopes please sketch and show depths.

GROUND LEVEL

			X

SECTION 17

Please indicate well location X.

ADDITIONAL INFORMATION

If more than one screen, show locations of each on sketch.