

HARRISON

L 486

4-29-76

MISSISSIPPI BOARD OF WATER COMMISSIONERS  
416 North State Street  
Jackson, Mississippi 39201

CODEU

WATER WELL DRILLERS LOG

April 29 1976  
date well completed

139  
MAB Drilling Co.  
firm name

Harrison  
county well located

LANDOWNER: P. J. C. Africa  
R.R. London Rd  
Culfoot, Miss.  
(mailing address)


description of formations encountered	from	to
Clay	0	15
Orange Clay	15	30
White Sand	30	55
White Clay	55	95
Blue Clay	95	172
Grey Sand	172	190
Medium Grey Sand	190	227
Blue Clay	227	230+

WELL LOCATION:  
sec. 17 T. 7 S. R. 11 W.  
3 miles N of Culfoot  
(distance) (direction) (nearest town)

WELL PURPOSE: Home  
(home, irrigation, municipal, industrial)

- WELL COMPLETION DATA:
- (1) diameter (inches) 2"
  - (2) total depth (feet) 230
  - (3) static water level (feet) 9 below top of ground.
  - (4) casing PRC Total  
(material) (depth)  
2"  
(size) If telescope see back.
  - (5) screen 10 217  
(length) (depth to top)  
2" PRC  
(size) (material)
  - (6) pump 1/2 10  
(HP) (yield gpm)  
110V 1P  
(type power)
  - (7) electric log N  
(yes or no)
  - (organization running log)
  - (8) how well bottom plugged 2" Cap.

CODED

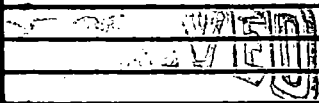

MAY 10 1976

DRILLERS REMARKS:

MISS. BD. OF WATER COMM.

If well telescopes please sketch and show depths.

GROUND LEVEL

			x

SECTION 12

Please indicate well location X.

ADDITIONAL INFORMATION

If more than one screen, show locations of each on sketch.