

HARRISON
 L 487
 6-10-76

MISSISSIPPI
 BOARD OF WATER COMMISSIONERS
 416 North State Street
 Jackson, Mississippi 39201

CODED

WATER WELL DRILLERS LOG

10 JUNE 1976 ¹³⁵ BRYANT Well Co HARRISON
 date well completed firm name county well located

LANDOWNER: EY COLEMAN
RT 1 BOX 200
EXT. Ms. 39501
 (mailing address)

WELL LOCATION:
 sec. B T 7 S R. 11 W
3 miles N of Outspout
 (distance) (direction) (nearest town)

WELL PURPOSE:
 Home Irrigation, municipal, industrial

WELL COMPLETION DATA:

- (1) diameter (inches) 2
- (2) total depth (feet) 535
- (3) static water level (feet) 25 below
top of ground
- (4) casing 2 530
(material) (depth)
- (size) if telescope see back.
- (5) screen 5 530
(length) (depth to top)
- 2 1/2 PVC
(size) (material)
- (6) pump 1 10
(HP) (yield gpm)
- ELECT
(type power)
- (7) electric log NO
(yes or no)
- (organization running log)

(8) how well bottom plugged METAL SAND SHANK

DRILLERS REMARKS:

description of formations encountered	from to	
<u>Red clay</u>	<u>0</u>	<u>19</u>
<u>White sand</u>	<u>19</u>	<u>33</u>
<u>White clay</u>	<u>33</u>	<u>52</u>
<u>Red sand</u>	<u>52</u>	<u>105</u>
<u>Blue clay</u>	<u>105</u>	<u>273</u>
<u>Light sand</u>	<u>273</u>	<u>293</u>
<u>Blue clay</u>	<u>293</u>	<u>476</u>
<u>Sand sand</u>	<u>476</u>	<u>535</u>


CODED

RECEIVED
 JUL - 8 1976

MISS. BD. OF WATER COMM

If well telescopes please sketch and show depths.

GROUND LEVEL

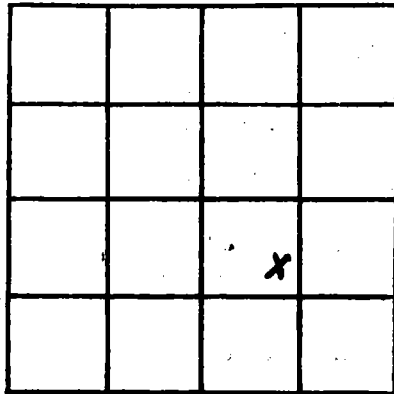

SECTION 8

Please indicate well location X.

ADDITIONAL INFORMATION

If more than one screen,
show locations of each on sketch.