

HARRISON
 L 491
 9/23/76

MISSISSIPPI
 BOARD OF WATER COMMISSIONERS
 416 North State Street
 Jackson, Mississippi 39201

CODED

WATER WELL DRILLERS LOG

Sept 23 1976 Bryant Well Co. HARRISON
 date well completed firm name county well located

LANDOWNER: John Hunter
43 Cambridge Rd.
Huffport Mo. 39501
 (mailing address)

description of formations encountered	from	to
clay	0	10
sand	10	15
clay	15	17
sand	17	28
clay	28	35
sand	35	41
clay	41	52
sand & gravel	52	65

WELL LOCATION:
 sec 25 T 7 N R 11 W
1 miles NE of PFT
 (distance) (direction) (nearest town)

WELL PURPOSE: Domestic
 (home, irrigation, municipal, industrial)

WELL COMPLETION DATA:

- (1) diameter (inches) 4" ~~4.5"~~
- (2) total depth (feet) 65'
- (3) static water level (feet) 18' ^{below} _{above} top of ground.
- (4) casing PVC 60'
 (material) (depth)
 (size) If telescope see back.
- (5) screen 5' 10'
 (length) (depth to top)
10' PVC
 (size) (material)
- (6) pump 1 20
 (HP) (yield gpm)
Electric
 (type power)
- (7) electric log None
 (yes or no)
- (organization running log)
- (8) how well bottom plugged Metal
AND STAIN

CODED


RECEIVED
 DEC 6 1976

MISS. BD. OF WATER COMMISSIONERS

DRILLERS REMARKS:

If well telescopes please sketch and show depths.

GROUND LEVEL

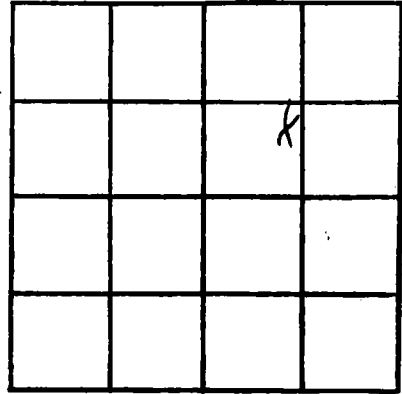

SECTION 25

Please indicate well location X.

ADDITIONAL INFORMATION

If more than one screen, show locations of each on sketch.