

Harrison
L 499
5/19/77

MISSISSIPPI
BOARD OF WATER COMMISSIONERS
416 North State Street
Jackson, Mississippi 39201

CODED

WATER WELL DRILLERS LOG

May 19 1977 date well completed
McNeil Well Works firm name
Harrison county well located

LANDOWNER: Pat Duckworth
1301 35th Ave.
Spt, Miss.
(mailing address)

description of formations encountered	from	to
Sand	0	30

WELL LOCATION:
sec. 5 T. 8 N. R. 11 E.
1 miles W of Spt.
(distance) (direction) (nearest town)

CODED

WELL PURPOSE:
(home, irrigation, municipal, industrial)

- WELL COMPLETION DATA:
- (1) diameter (inches) 2"
 - (2) total depth (feet) 30'
 - (3) static water level (feet) 2' below top of ground
 - (4) casing 2" sch 40 PVC 20'
(material) (depth)
 - (size) if telescope see back.
 - (5) screen 10' (length) (depth to top)
2" plastic (size) (material)
 - (6) pump 1/2 HP 11 (yield gpm)
electric (type power)
 - (7) electric log no (yes or no)
 - (organization running log)
 - (8) how well bottom plugged clogged


RECEIVED
JAN 18 1978

MISS. BB. OF WATER COMMISSIONERS

DRILLERS REMARKS:

If well telescopes please sketch and show depths.

GROUND LEVEL

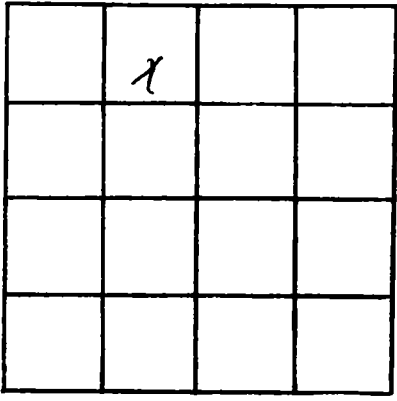

SECTION 5

Please indicate well location X.

ADDITIONAL INFORMATION

A series of horizontal lines for writing additional information, starting below the 'ADDITIONAL INFORMATION' header and extending to the bottom of the page.

If more than one screen, show locations of each on sketch.