

HARRISON
L 500

MISSISSIPPI
BOARD OF WATER COMMISSIONERS
416 North State Street
Jackson, Mississippi 39201

CODED

May 25, 1977

WATER WELL DRILLERS LOG

May 25 1977 *Duncan Well Drilling Harrison*
date well completed firm name county well located

LANDOWNER:

description of formations encountered

from to

Dennis Braun Jr.
(~~4152nd~~ street)
Gulfport, MS.
(mailing address)

soil 0 5
sand 5 20
blue clay 20 45
course sand 45 65

WELL LOCATION:

sec. 25 T. 1 N. R. 10 E
two miles SE of Gulfport
(distance) (direction) (nearest town)

WELL PURPOSE:

(home, irrigation, municipal, industrial)

CODED

WELL COMPLETION DATA:

- (1) diameter (inches) 2"
- (2) total depth (feet) 65
- (3) static water level (feet) 12 ^{below}/_{above} top of ground.
- (4) casing PVC, 55, (material) (depth)
if telescope see back.
(size)
- (5) screen 10', 55 (length) (depth to top)
2" PKS sch. 40 (size) (material)
- (6) pump 1/2, 12 (HP) (yield gpm)
electric (type power)
- (7) electric log (yes or no)
(organization running log)
- (8) how well bottom plugged Sand
Shark


RECEIVED
JUN 23 1977

DRILLERS REMARKS:

MISS. BD. OF WATER

If well telescopes please sketch and show depths.

GROUND LEVEL

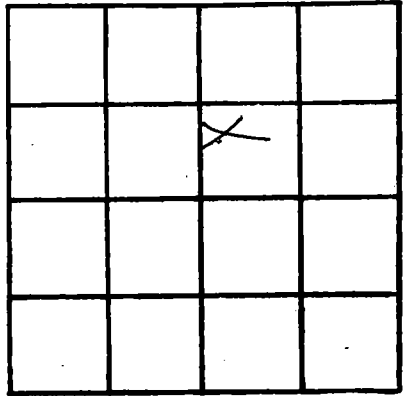

SECTION 25

Please indicate well location X.

ADDITIONAL INFORMATION

A series of horizontal lines for writing additional information.

If more than one screen, show locations of each on sketch.