

HARRISON
 L512
 3-24-78

MISSISSIPPI
 BOARD OF WATER COMMISSIONERS
 416 North State Street
 Jackson, Mississippi 39201

CODED

WATER WELL DRILLERS LOG

March 24 1978 Duncan Well Drilling Harrison
 Date well completed firm name county well located

LANDOWNER: Joe Kelley
 1014 W. Pine Lot 7
 Gulfport Ms.
 (mailing address)

description of formations encountered	from	to
Soil	0	10
Sand	10	60
Blue Clay	60	180
Gravel Sand	180	240
Coarse Sand	240	273

WELL LOCATION:
 sec 30 T 7 N R 11 E
 1 1/2 miles NW of Gulfport
 (distance) (direction) (nearest town)

CODED

WELL PURPOSE: Home
 (home, irrigation, municipal, industrial)

- WELL COMPLETION DATA:
- (1) diameter (inches) 2 1/2
 - (2) total depth (feet) 273
 - (3) static water level (feet) 5 ^{below} _{above} top of ground.
 - (4) casing PVC, 263
 (material) (depth)
 - _____ If telescope see back.
 (size)
 - (5) screen 10', 263
 (length) (depth to top)
 2" PVC SCH-40
 (size) (material)
 - (6) pump 1 15
 (HP) (yield gpm)
 electric
 (type power)
 - (7) electric log NO
 (yes or no)

(organization running log)
 (8) how well bottom plugged Sand
 Shark

DRILLERS REMARKS:


RECEIVED

AUG 11 1978

MISS. BD. OF WATER COMMISSIONERS

If well telescopes please sketch and show depths.

GROUND LEVEL

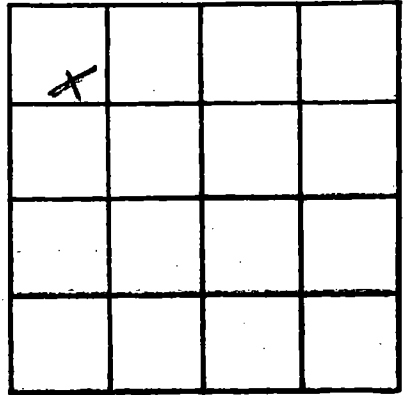

SECTION 30

Please indicate well location X.

ADDITIONAL INFORMATION

If more than one screen, show locations of each on sketch.