

HARRISON  
 L 520  
 4-2-78

MISSISSIPPI  
 BOARD OF WATER COMMISSIONERS  
 416 North State Street  
 Jackson, Mississippi 39201

CODED

WATER WELL DRILLERS LOG

April 2 1978 Simons Well Drilling Harrison  
 date well completed firm name county well located

LANDOWNER: Vernice Conner  
Rt. 1 Box 230  
Long Beach, Ms.  
 (mailing address)

WELL LOCATION:  
 sec. 12 T. 7 N. R. 11 E.  
1 miles N of Long Beach  
 (distance) (direction) (nearest town)

WELL PURPOSE: Home  
 (home, irrigation, municipal, industrial)

WELL COMPLETION DATA:

- (1) diameter (inches) 2"
- (2) total depth (feet) 777'
- (3) static water level (feet) 13 <sup>below</sup> <sub>above</sub> top of ground.
- (4) casing pvc 767'  
 (material) (depth)
- If telescope see back.  
 (size)
- (5) screen 10' 767'  
 (length) (depth to top)
- 2" pvc sch. 40  
 (size) (material)
- (6) pump 1 14  
 (HP) (yield gpm)
- electric  
 (type power)
- (7) electric log No  
 (yes or no)

(organization running log)

(8) how well bottom plugged Sand  
Shark

DRILLERS REMARKS:

description of formations encountered	from	to
top sand	0	40
blue clay	40	200
fine sand	200	250
blue clay	250	500
fine sand	500	600
blue clay	600	650
fine sand	650	690
blue clay	690	710
fine sand	710	750
concrete pad	750	777


CODED

RECEIVED

AUG 11 1978

If well telescopes please sketch and show depths.

GROUND LEVEL

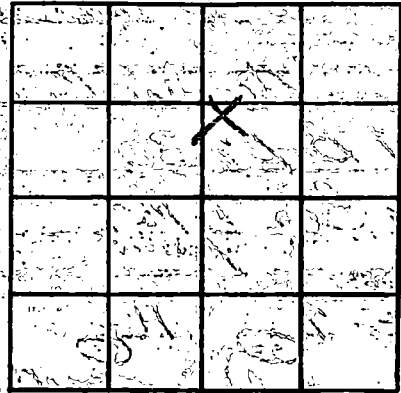

SECTION 12

Please indicate well location X.

ADDITIONAL INFORMATION

If more than one screen, show locations of each on sketch.